	/ell Report	For Office Use Only:
	Part 1	Aquifer:
Mississippi Department	nt of Environmental Quality and Water Resources	Well #: E-121
P.O.	Box 10631	L. S. Elevation:
	AS 39289-0631)961-5210	
	54-6938 (fax)	E-log #:
State Law requires that this report be prepared by the 30 days of completion of drilling of the well.	e driller in detail and filed v	with the Department within
Well Owner Information		ll Location
Dwner Name Range Production Co	Latitude: <u>31 • 16 • 45</u>	
Mailing Address: P.O.Box 2229	Method of Lat/Long (circle o	one): Conventional Survey,
	USGS quad, Hand-hel	d GPS, Survey-grade GPS
Houston TX 77252	<u>SE 14 SE 14 Sec 2</u>	9 Jun 4N Rng E/3
City State Zip Code	Distance Direction	of <u>Columbia</u>
Telephone No. (60) 441-3073		
Wel	Data	
Purpose of Well (circle one) Home Industrial Public Supply	Irrigation Fish Culture	(other:) Rig Supply
- ·	e well drilling completed: <u>5</u>	11/108
If flowing, method of flow regulation: Valve Other	(describe)	
Static Water Level:85feet above or below (circle one) land surface Date measured	1: 5/17/08
Method of Measurement (circle one) steel tape electric ta	pe) air line other:	
Hole depth: <u>240'</u> Well depth: <u>240'</u>	Well grouted to a depth of	ffeet
Type of grout (circle one): Cement Bentonite Mi		Dute
Casing length: <u>220</u> feet Casing diameter: <u>4</u>	inches Type of casing:	PVC
Screen length: <u>20</u> feet Screen diameter: <u>4</u>	inches Type of screen:	<u>PVC</u>
Screen slot size: <u>020</u> inches Setting depth: From	n <u>220</u> feet to	·
Type of completion (circle all applicable): Gravel packed Un	derreamed Telescoped Op	en hole Natural Development
		······································
Top of lap pipe or reduction in casing:feet. I	f telescoped or more than one s	screen, describe on back of page
Logs run (circle all applicable): No log run Electric Gamma F	ay Density Sonic Neutron	Other:
Name of organization running log(s):	in accordance with all applicat	ble requirements of the Mississippi
Department of Environmental Quality and/or the Mississippi	Department of Health regulation	ons and state laws.
Rayborn Drilling, Inc. O	-60 - J	
Print Name of Water Well Contractor and License No.	Signatur	of Water Well Contractor
L		RECEIV
a second and the second sec		MAY 3 0 20
		BY: OLV


1

If well telescopes please sketch below and show depths.

Ground Level

now depths.		F	- / e
	Description of Formations Encountered	From	To
	Chalk	0	20
	Sand and Gravel	20	90
	CHALK	90	180
	FINE SAND	180	200
	Medium SAND	200	240
			+-

If more than one screen, show location of each on sketch

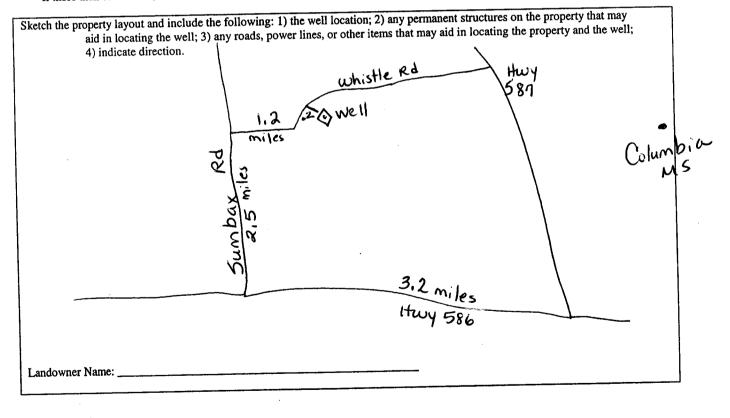

Signature of Water Well Contractor

MAY 3 0 2008 BY: OLWR

		ELL REPORT	
County: Marion		Part 2 's Completion Report	For Office Use Only:
Permit #:	Pump Installer's Completion Report Mississippi Department of Environmental Quality		Aquifer:
Permit #:	Office of Land and Water Resources P.O. Box 10631		E 121
Driller: Gary Rayborn	Jackson, I	MS 39289-0631	Well #: F-121
Date completed: 51708		.)961-5210 54-6938 (fax)	Elevation:
			ment within 30 days of the
This report should be prepared by th installation of pump.			
Well Owner Informat	_		Vell Location
Owner Name: Range Produ	iction Co	Latitude:	Longitude:
Mailing Address: P.O.BOX 2	229	Method of Lat/Long (circle	e one): Conventional Survey,
-		USGS quad, H	and-held GPS, Survey-grade GPS
Houston T)	(77252	-	29 Twn 4N Rng 13E
City State	Zip Code		
·	-	Distance Direction	
Telephone No. (601) 441 - 30	13	Miles West	of Columbia
-			
Ритр Туре			Power Type
Circle one	·		Circle one
Air Lift Jet	Submersible	Diesel Engine Gas	soline Engine Natural Gas
Bucket Piston	Turbine	Electric Motor Ha	nd Tractor PTO
Centrifugal Rotary	Flowing Well	Windmill Ot	her (specify):
	Tiowing tron		otor: <u>5</u>
Other (specify):	~ 0	Horse Power Rating of Mi	
Date Pump Installed: 517	08	Setting Depth:	feet
Rated Pump Capacity: 60	Gallons Per Minute	Number of Stages:	11
Pump Test Data		Method of	Measuring Water Level Circle one
Date Well Tested: 51170	8		
07	t Below Land Surface	Air Line Electric	Measuring Line Steel Tape
		Other (specify):	
Pumping Water Level (B):Fee	t Below Land Surface		
Drawdown [(B) – (A)]:Fee	et Below Land Surface	For flowing well, measure	ed shut in head:feet
Test Pumping Rate: 60	Gallons Per Minute	Well yielded	GPM with a drawdown of
	_	, i i i i i i i i i i i i i i i i i i i	
Duration of Pump Test (minimum 4 hours):hours	teet af	terhours of pumpin
······	·····	· · · · · · · · · · · · · · · · · · ·	
I HEREBY CERTIFY that the above state	ments are true to the bes	t of my knowledge.	
	O - (o O)	\sim	x
Print Name of Pump Installer and License		Signature & Pur	np Installer
			REC
	•		7 & Barro Dover

·