

Marion
 E 2000,
 6-75

MISSISSIPPI
 BOARD OF WATER COMMISSIONERS
 416 North State Street
 Jackson, Mississippi 39201

WATER WELL DRILLERS LOG

June 75 date well completed
 E.B. Sherrard firm name
 Marion county well located

LANDOWNER:

Mrs. L. A. Newsom
 Columbia, Ms.
 (mailing address)

description of formations encountered

SAND + GRAVEL

from

to

0

38'

WELL LOCATION:

sec. 7 T 45 N R 19 E 13V
 6 miles NW of Columbia
 (distance) (direction) (nearest town)

WELL PURPOSE:

(home) irrigation, municipal, industrial

WELL COMPLETION DATA:

- (1) diameter (inches) 2"
- (2) total depth (feet) 33'
- (3) static water level (feet) 14' below top of ground.
- (4) casing pl. 33' (material) (depth)
 2" if telescope see back. (size)
- (5) screen 5' (length) (depth to top)
 2" pl. (size) (material)
- (6) pump 1/2 (HP) 8 (yield gpm)
 E (type power)
- (7) electric log (yes or no)

(organization running log)

- (8) how well bottom plugged B.W.V.


DRILLERS REMARKS:

INSPECTION
 DEC - 5 1975

MISS. BD. OF WATER COMMISSIONERS

If well telescopes please sketch and show depths.

GROUND LEVEL

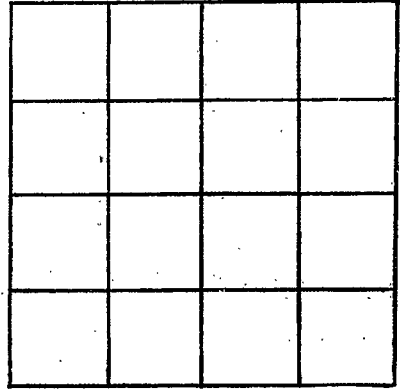

SECTION _____

Please indicate well location X.

ADDITIONAL INFORMATION

If more than one screen, show locations of each on sketch.