

Marion  
F 2001  
6-75

MISSISSIPPI  
BOARD OF WATER COMMISSIONERS  
416 North State Street  
Jackson, Mississippi 39201

WATER WELL DRILLERS LOG

June 25 1975 E.B. Sherrard Marion  
date well completed firm name county well located

LANDOWNER:

Dale Price  
Pt. 1, Foxworth, Ms.  
(mailing address)

description of formations encountered

from to

BLUE CLAY 0 10'  
COARSE SAND 10' 65'

WELL LOCATION:

sec 23 T. 4 N R. 19 E  
S  
4 miles NW of Columbia  
(distance) (direction) (nearest town)

WELL PURPOSE:

(home, irrigation, municipal, industrial)

WELL COMPLETION DATA:

- (1) diameter (inches) 2"
- (2) total depth (feet) 65'
- (3) static water level (feet) 24' below top of ground.
- (4) casing pl. 60'  
(material) (depth)  
2" If telescope see back.  
(size)
- (5) screen 5'  
(length) (depth to top)  
2" pl.  
(size) (material)
- (6) pump 1/2 6  
(HP) (yield gpm)  
E  
(type power)
- (7) electric log (yes or no)

(organization running log)


(8) how well bottom plugged B/W

DRILLERS REMARKS:

RECEIVED  
DEC 5 1975  
MISS. BD. OF WATER COMM.

If well telescopes please sketch and show depths.

GROUND LEVEL

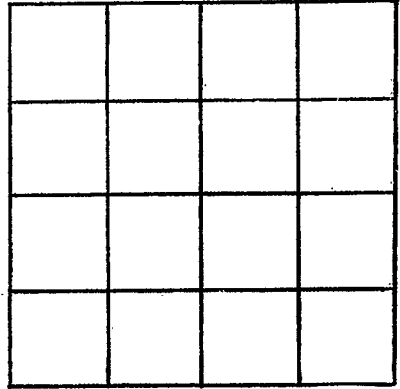

SECTION \_\_\_\_\_

Please indicate well location X.

ADDITIONAL INFORMATION

If more than one screen,  
show locations of each on sketch.