

Marion
 F 2002
 8-75

MISSISSIPPI
 BOARD OF WATER COMMISSIONERS
 416 North State Street
 Jackson, Mississippi 39201

WATER WELL DRILLERS LOG

August 25 1975 E. B. Sheppard Marion
 date well completed firm name county well located

LANDOWNER:
 Joe Owens
 Columbia, Ms.
 (mailing address)


description of formations encountered	from	to
RED CLAY CR.	0	40'
SANDY CLAY	40	80'
DEA BR SAND	80	97'

WELL LOCATION:
 sec 12 T 4 N R 19 E 13V
 4 miles NW of Columbia
 (distance) (direction) (nearest town)

WELL PURPOSE:
 (home) irrigation, municipal, industrial

- WELL COMPLETION DATA:
- (1) diameter (inches) 2"
 - (2) total depth (feet) 97'
 - (3) static water level (feet) 60' ^{below} above top of ground.
 - (4) casing pl. (material) 92' (depth)
 2" (size) if telescope see back.
 - (5) screen 5' (length) (depth to top)
 2" (size) pl. (material)
 - (6) pump 1 (HP) 7 (yield gpm)
 E (type power)
 - (7) electric log (yes or no) no
 - (8) how well bottom plugged BWV


DRILLERS REMARKS:

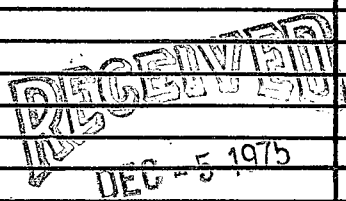

MISS. BD. OF WATER COMMISSIONERS

If well telescopes please sketch and show depths.

GROUND LEVEL

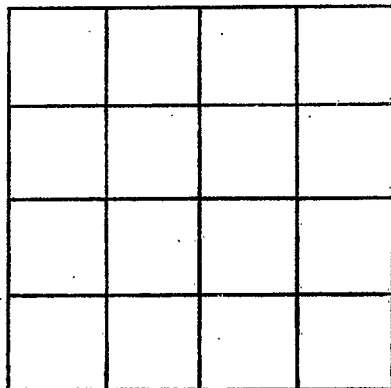

SECTION _____

Please indicate well location X.

ADDITIONAL INFORMATION

If more than one screen, show locations of each on sketch.