

Marion  
 F 2003  
 7-75

MISSISSIPPI  
 BOARD OF WATER COMMISSIONERS  
 416 North State Street  
 Jackson, Mississippi 39201

WATER WELL DRILLERS LOG

July 25 1975 E.B. Sherman & Marion  
 date well completed firm name county well located

LANDOWNER:  
 Cecil Stephenson  
 Columbia, Mo.  
 (mailing address)

| description of formations encountered | from | to   |
|---------------------------------------|------|------|
| GRAY CHALK                            | 0    | 25'  |
| SAND & CLAY STREAKS                   | 25   | 80'  |
| FINE SAND                             | 80   | 100' |
| COARSE SAND & GRAVEL                  | 100  | 120' |

WELL LOCATION:  
 sec. 1 T. 4 N. R. 19 E. 13V  
 4 miles NW of Columbia  
 (distance) (direction) (nearest town)

WELL PURPOSE:  
 (home) irrigation, municipal, industrial

WELL COMPLETION DATA:

(1) diameter (inches) 2"

(2) total depth (feet) 120'

(3) static water level (feet) 40' <sup>below</sup> <sub>above</sub> top of ground.

(4) casing pl. 125' (material) (depth)  
 2" (size) if telescope see back.

(5) screen 5' (length) (depth to top)  
 2" (size) pl. (material)

(6) pump 3/4 (HP) 7 (yield gpm)  
 E (type power)

(7) electric log (yes or no)  no

(organization running log)

(8) how well bottom plugged BWV


DRILLERS REMARKS:

RECEIVED  
 DEC 5 1975

MISS. BD. OF WATER COMMISSIONERS

If well telescopes please sketch and show depths.

GROUND LEVEL

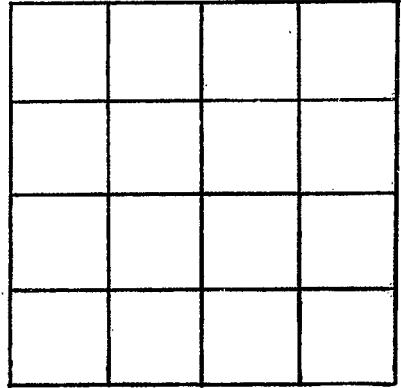

SECTION \_\_\_\_\_

Please indicate well location X.

ADDITIONAL INFORMATION

If more than one screen,  
show locations of each on sketch.