

Marion  
E. 2004  
8-75

MISSISSIPPI  
BOARD OF WATER COMMISSIONERS  
416 North State Street  
Jackson, Mississippi 39201

WATER WELL DRILLERS LOG

August 1975 E.B. Sherwood Marion  
date well completed firm name county well located


LANDOWNER:	description of formations encountered	from	to
Ken Morgan	BLUE CLAY	0	240
Morgan, Ms. (mailing address)	COARSE SAND	240	282
<b>WELL LOCATION:</b>			
sec. 23 T. 4 N R. 14 E S. 19 W 18 W			
5 miles NW of Columbia			
<b>WELL PURPOSE:</b> (home) Irrigation, municipal, industrial			
<b>WELL COMPLETION DATA:</b>			
(1) diameter (inches) 2"			
(2) total depth (feet) 282'			
(3) static water level (feet) 20' <sup>below</sup> top of ground.			
(4) casing <u>pl.</u> 272' (material) (depth)			
2" (size) if telescope see back.			
(5) screen 10' (length) (depth to top)			
2" (size) pl. (material)			
(6) pump 1/3 (HP) 7 (yield gpm)			
E (type power)			
(7) electric log (yes or no)			
(organization running log)			
(8) how well bottom plugged BWV			
<b>DRILLERS REMARKS:</b>			

RECEIVED  
DEC 5 1975

MISS. BD. OF WATER COMMISSIONERS

If well telescopes please sketch and show depths.

GROUND LEVEL

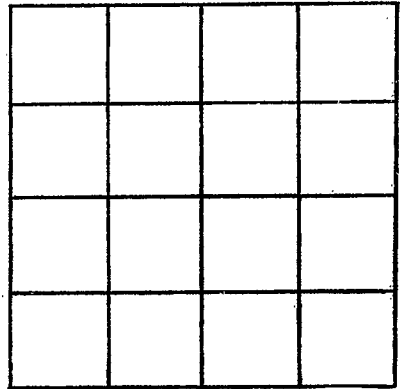

SECTION \_\_\_\_\_

Please indicate well location X.

ADDITIONAL INFORMATION

If more than one screen,  
show locations of each on sketch.