

Marion  
 F 2005  
 9/75

MISSISSIPPI  
 BOARD OF WATER COMMISSIONERS  
 416 North State Street  
 Jackson, Mississippi 39201


WATER WELL DRILLERS LOG

Sept. 25 E. B. Sheppard Marion  
 date well completed firm name county well located

| LANDOWNER:  | description of formations encountered          | from | to  |
|---|--|------|-----|
| Lucy Expose<br>Columbia, Ms.<br>(mailing address)   | SAND & GRAVEL                                  | 0    | 40' |
| <b>WELL LOCATION:</b><br>sec 12 T 4 N R 19 E 131<br>S W<br>3 miles NW Columbia<br>(distance) (direction) (nearest town)   |  |      |     |
| <b>WELL PURPOSE:</b><br>(home, irrigation, municipal, industrial)   |  |      |     |
| <b>WELL COMPLETION DATA:</b><br>(1) diameter (inches) 2"<br>(2) total depth (feet) 40'<br>(3) static water level (feet) 18' below top of ground.<br>(4) casing pl. 35' (material) (depth)<br>2" (size) if telescope see back.<br>(5) screen 5' (length) (depth to top)<br>2" (size) pl. (material)<br>(6) pump 1/2 (HP) 8 (yield gpm)<br>E (type power)<br>(7) electric log (yes or no) <u>no</u><br>(organization running log)<br>(8) how well bottom plugged <u>BWV</u> |  |      |     |
| <b>DRILLERS REMARKS:</b>  | DEC 5 1975<br>MISS. BD. OF WATER COMMISSIONERS |      |     |

If well telescopes please sketch and show depths.

GROUND LEVEL

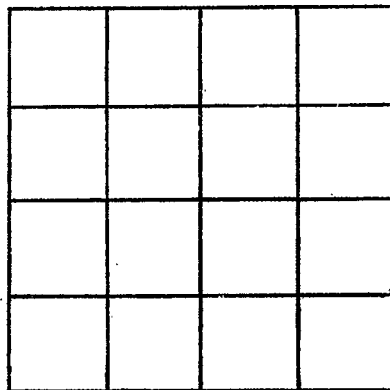

SECTION \_\_\_\_\_

Please indicate well location X.

ADDITIONAL INFORMATION

If more than one screen, show locations of each on sketch.