

Marion
F 2006.
10/75

MISSISSIPPI
BOARD OF WATER COMMISSIONERS
416 North State Street
Jackson, Mississippi 39201

WATER WELL DRILLERS LOG

Oct. 1975 E. B. Sherrard Marion
date well completed firm name county well located

LANDOWNER:
Vernon Beal
Jayworth, Ms.
(mailing address)

description of formations encountered	from	to
GRAVEL SAND/CLAY	0	14
GRAVEL & SAND	14	20
BLUE CLAY	20	25
FINE SAND	25	110
COARSE SAND		
MIXED SAND		
PIEA GR.	110	120

WELL LOCATION:
sec. 27 T. 4 N. R. 13 E. S. 5
2 1/2 miles N of Jayworth
(distance) (direction) (nearest town)

WELL PURPOSE:
(home, irrigation, municipal, industrial)

WELL COMPLETION DATA:


- (1) diameter (inches) 2"
- (2) total depth (feet) 120'
- (3) static water level (feet) 1 ft ^{below} top of ground.
- (4) casing pl. 115' (material) (depth)
2" if telescope see back. (size)
- (5) screen 5' (length) (depth to top)
2" (size) pl. (material)
- (6) pump 1/3 (HP) 10 (yield gpm)
E (type power)
- (7) electric log (yes or no) (no)
(organization running log)
- (8) how well bottom plugged BWV

DRILLERS REMARKS:

REGISTERED
DEC - 5 1975
MISS. BD. OF WATER COMM.

If well telescopes please
sketch and show depths.

GROUND LEVEL

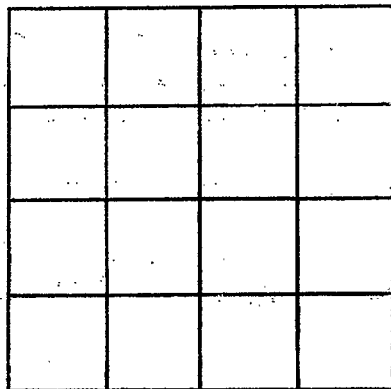

SECTION _____

Please indicate well location X.

ADDITIONAL INFORMATION

If more than one screen,
show locations of each on sketch.