

Marion
 F 2007
 11/75

MISSISSIPPI
 BOARD OF WATER COMMISSIONERS
 416 North State Street
 Jackson, Mississippi 39201


WATER WELL DRILLERS LOG

Nov 25 1975 E.B. Sherrard Marion
 date well completed firm name county well located

LANDOWNER:	description of formations encountered	from to
Archie Sherrill Foxworth, Ms. (mailing address)	R.F.D. SANDY CLAY BLUE SLATE CLAY COARSE SAND ONLY	0 45 45 135 135 157
WELL LOCATION: sec 36 T. 4 N. R. 19 E 4 miles NW Foxworth (distance) (direction) (nearest town)		
WELL PURPOSE: <input checked="" type="checkbox"/> home irrigation, municipal, industrial		
WELL COMPLETION DATA: (1) diameter (inches) 2" (2) total depth (feet) 157' (3) static water level (feet) 60' below top of ground. (4) casing (material) plc (depth) 152' (size) 2" if telescope see back. (5) screen (length) 5' (depth to top) (size) 2" (material) plc (6) pump (HP) 1 (yield gpm) 7 (type power) e (7) electric log (yes or no) (no) (organization running log) (8) how well bottom plugged BWV		
DRILLERS REMARKS:	RECEIVED DEC - 5 1975 MISS. BD. OF WATER COMM.	

If well telescopes please
sketch and show depths.

GROUND LEVEL

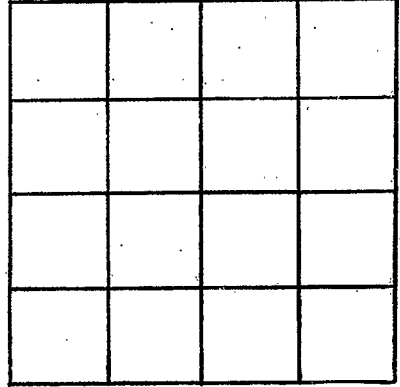

SECTION _____

Please indicate well location X.

ADDITIONAL INFORMATION

If more than one screen,
show locations of each on sketch.