

Marion
 F 2008
 11/75

MISSISSIPPI
 BOARD OF WATER COMMISSIONERS
 416 North State Street
 Jackson, Mississippi 39201

WATER WELL DRILLERS LOG

Nov 1975 E.B. Sheppard Marion
 date/well completed firm name county/well located


LANDOWNER:	description of formations encountered	from	to
A. T. Robertson Columbia, Ms. (mailing address)	GRAY HARD CLAY SAND & GRAVEL	0 45	25' 38'
WELL LOCATION:			
sec <u>2</u> T <u>4</u> N R <u>19</u> E 13V <u>4 1/2</u> miles NW Columbia (distance) (direction) (nearest town)			
WELL PURPOSE:			
<input checked="" type="checkbox"/> home <input type="checkbox"/> irrigation, municipal, industrial			
WELL COMPLETION DATA:			
(1) diameter (inches) <u>2"</u>			
(2) total depth (feet) <u>38'</u>			
(3) static water level (feet) <u>28'</u> ^{below} above top of ground.			
(4) casing <u>pl</u> <u>33'</u> (material) (depth)			
<u>2"</u> If telescope see back. (size)			
(5) screen <u>5'</u> (length) (depth to top)			
<u>2"</u> <u>pl</u> (size) (material)			
(6) pump <u>2</u> <u>7</u> (HP) (yield gpm)			
<u>E</u> (type power)			
(7) electric log (yes or no) <input checked="" type="checkbox"/>			
(organization running log)			
(8) how well bottom plugged <u>BWV</u>			
DRILLERS REMARKS:			

RECEIVED
 DEC 5 1975

MISS. BD. OF WATER COMM

If well telescopes please sketch and show depths.

GROUND LEVEL

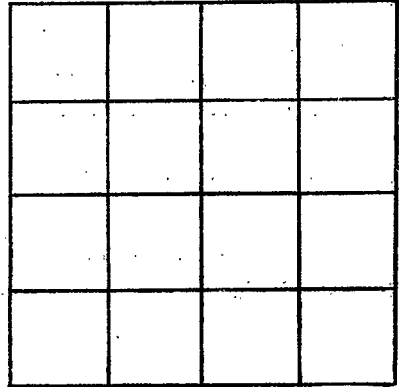

SECTION _____

Please indicate well location X.

ADDITIONAL INFORMATION

If more than one screen,
show locations of each on sketch.