

Marion  
 F 2009  
 11/75

MISSISSIPPI  
 BOARD OF WATER COMMISSIONERS  
 416 North State Street  
 Jackson, Mississippi 39201

WATER WELL DRILLERS LOG

Nov 1975 E.B. Sheppard Marion  
 date well completed firm name county well located

LANDOWNER:

Mary Etta Jacobs  
 Columbia, Mo.  
 (mailing address)

description of formations encountered

from to

RED SANDY CLAY	0	70
SAND & PEA GR.	70	125

WELL LOCATION:

sec 12 T 4 N R 19 E 13 V  
 S W  
 4 miles N Columbia  
 (distance) (direction) (nearest town)

WELL PURPOSE:

(home) Irrigation, municipal, industrial

WELL COMPLETION DATA:

- (1) diameter (inches) 2"
- (2) total depth (feet) ~~125~~ 125
- (3) static water level (feet) 60 below top of ground
- (4) casing pl 120' (material) (depth)  
 2" (size) If telescope see back.
- (5) screen 5' (length) (depth to top)  
 2" pl (size) (material)
- (6) pump 1 (HP) 7 (yield gpm)  
 E (type power)
- (7) electric log (yes or no) (no)
- (8) how well bottom plugged BWV


DRILLERS REMARKS:

RECORDED  
 DEC - 5 1975

MISS. BD. OF WATER COMM.

If well telescopes please sketch and show depths.

GROUND LEVEL

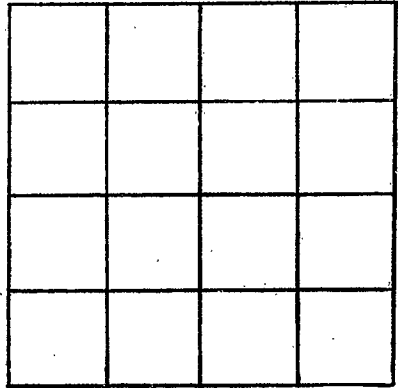

SECTION \_\_\_\_\_

Please indicate well location X.

ADDITIONAL INFORMATION

If more than one screen, show locations of each on sketch.