

Marion
F 2010
12/75

MISSISSIPPI
BOARD OF WATER COMMISSIONERS
416 North State Street
Jackson, Mississippi 39201

WATER WELL DRILLERS LOG

~~Dec~~ Feb 25 1975 E. B. Sheppard Marion
date well completed firm name county well located

LANDOWNER:
Donnie Beal
Fayworth, MS.
(mailing address)

description of formations encountered	from	to
<u>GRAY SANDY CLAY</u>	<u>0</u>	<u>14'</u>
<u>GRAVEL & SAND</u>	<u>14</u>	<u>19'</u>
<u>BLUE CLAY</u>	<u>19</u>	<u>90'</u>
<u>FINE SAND</u>	<u>90</u>	<u>110'</u>
<u>COARSE SAND & SOME PEABOK.</u>	<u>110</u>	<u>138'</u>

WELL LOCATION:
sec 27 T 4 N R 19 E
S 5 SW
2 1/2 miles N of Fayworth
(distance) (direction) (nearest town)

WELL PURPOSE:
(home, irrigation, municipal, industrial)

- WELL COMPLETION DATA:
- (1) diameter (inches) 2"
 - (2) total depth (feet) 138'
 - (3) static water level (feet) 14' ^{below} top of ground. _{above}
 - (4) casing pl 133'
(material) (depth)
2" If telescope see back.
(size)
 - (5) screen 5' pl
(length) (depth to top)
2" pl
(size) (material)
 - (6) pump 1/3 10
(HP) (yield gpm)
E
(type power)
 - (7) electric log (yes or no) (no)
(organization running log)
 - (8) how well bottom plugged BWV


REGISTERED
DEC 5 1975

DRILLERS REMARKS:

MISS. BD. OF WATER COMMISSIONERS

If well telescopes please sketch and show depths.

GROUND LEVEL

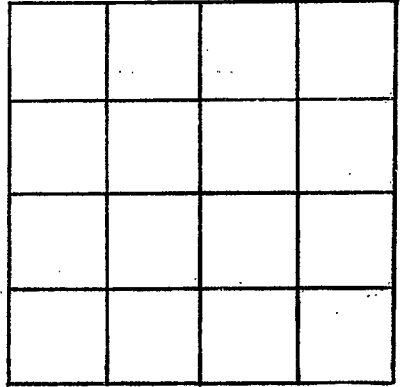

SECTION _____

Please indicate well location X.

ADDITIONAL INFORMATION

If more than one screen, show locations of each on sketch.