

Marion
 F 2012
 4/25/77

MISSISSIPPI
 BOARD OF WATER COMMISSIONERS
 416 North State Street
 Jackson, Mississippi 39201

WATER WELL DRILLERS LOG

4/25 1977 Hollinger Plumbing Marion
 date well completed firm name county well located

LANDOWNER: <u>Jessie Newson</u> <u>Rt 4</u>	description of formations encountered	from	to
<u>Columbia Miss</u> (mailing address)	<u>CLAY SAND, GRAVEL</u>	<u>0</u>	<u>15</u> <u>80</u>

WELL LOCATION:
 sec. 12 T. 4 (N) R. 19 (E) W. 5
City Limits of expose
 (distance) miles (direction) (nearest town)

WELL PURPOSE: Home
 (home, irrigation, municipal, industrial)

- WELL COMPLETION DATA:
- (1) diameter (inches) 2"
 - (2) total depth (feet) 80
 - (3) static water level (feet) 16 below above top of ground.
 - (4) casing PVC 75
 (material) (depth)
 (size) If telescope see back.
 - (5) screen 5 75
 (length) (depth to top)
2" PVC
 (size) (material)
 - (6) pump 1/2 7
 (HP) (yield gpm)
elect
 (type power)
 - (7) electric log _____
 (yes or no)


 (organization running log)
 - (8) how well bottom plugged sand
SHARIC

DRILLERS REMARKS: good well

RECEIVED
 JUN 15 1977
 MISS. BD. OF WATER COMMISSIONERS

If well telescopes please sketch and show depths.

GROUND LEVEL

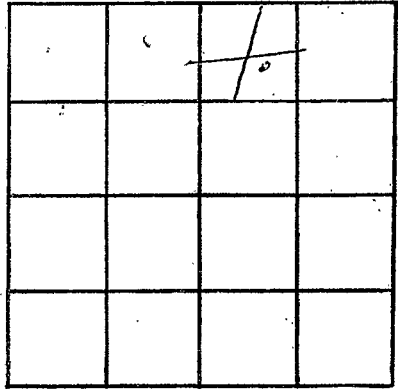

SECTION 12

Please indicate well location X.

ADDITIONAL INFORMATION

If more than one screen, show locations of each on sketch.