

MARION

F 2015

7-29-78

MISSISSIPPI BOARD OF WATER COMMISSIONERS  
416 North State Street  
Jackson, Mississippi 39201

WATER WELL DRILLERS LOG

TOM GRIFFITH

PLUMBING & WELL SERVICE, INC.

320 MAYSON AVE.

Marion county well located

9-29 1978 date well completed:

LANDOWNER:

Mr. Hurlie Ratchiff  
Rt. 1 - Jolworth, Miss.  
(mailing address)

COLUMBIA, MS 39429  
description of formations encountered

from to

Top Soil	0	1
Loam	1	14
Gravel & Sand	14	37
Chalk	37	49
Hard & Heavy	49	56
Sand	56	84

WELL LOCATION:

sec. 35 T 4 N R 13 E  
S W  
4 miles W of Jolworth  
(distance) (direction) (nearest town)

WELL PURPOSE: Home  
(home, irrigation, municipal, industrial)

WELL COMPLETION DATA:

- (1) diameter (inches) 2"
- (2) total depth (feet) 84 ft.
- (3) static water level (feet) 25 ft. below top of ground.
- (4) casing Plastic 74 ft. (material) (depth)  
2" (size) if telescope see back.
- (5) screen 10 ft. 74 ft. (length) (depth to top)  
2" (size) Plastic (material)
- (6) pump No pump (HP) (yield gpm)  
Electric (type power)
- (7) electric log No (yes or no)

(organization running log)

(8) how well bottom plugged B. W. Valve

DRILLERS REMARKS:


RECEIVED

OCT 10 1978

MISS. Bd. of WATER COMMISSIONERS

If well telescopes please sketch and show depths.

GROUND LEVEL

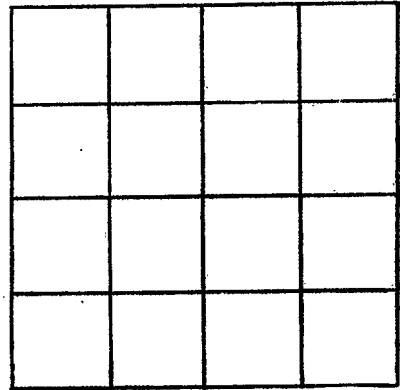

SECTION \_\_\_\_\_

Please indicate well location X.

ADDITIONAL INFORMATION

If more than one screen, show locations of each on sketch.