

MARION
 F 2017
 10-10-78
 10/10-

MISSISSIPPI
 BOARD OF WATER COMMISSIONERS
 416 North State Street
 Jackson, Mississippi 39201

WATER WELL DRILLERS LOG

TOM GRIFFITH

PLUMBING & WELL SERVICE, INC.
 firm name

marion
 county well located

LANDOWNER:

Mr. John Burdett
 Jopvout, Miss.
 (mailing address)

description of formations encountered

from to

Top soil	0	1
clay	1	20
loam & sand	20	42
clay	42	98
sand	98	149
clay	149	190
sand	190	210

WELL LOCATION:

sec 32 T 4 N R 13 E
 S W
 3 miles W of Jopvout
 (distance) (direction) (nearest town)

WELL PURPOSE: Home
 (home, irrigation, municipal, industrial)

WELL COMPLETION DATA:

- (1) diameter (inches) 4"
- (2) total depth (feet) 200ft.
- (3) static water level (feet) 130ft. below top of ground.
- (4) casing plastic, 180ft. (material) (depth)
 4" (size) if telescope see back.
- (5) screen 20ft, 180ft. (length) (depth to top)
 4" plastic (size) (material)
- (6) pump 1HP 10 (HP) (yield gpm)
 Electric (type power)
- (7) electric log no- (yes or no)

(organization running log)

(8) how well bottom plugged
 Back Wash Valve


DRILLERS REMARKS:

RECEIVED
 DEC 13 1978

MISS. BD. OF WATER COMMISSIONERS

If well telescopes please sketch and show depths.

GROUND LEVEL

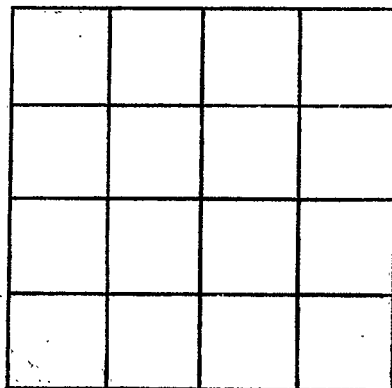

SECTION _____

Please indicate well location X.

ADDITIONAL INFORMATION

If more than one screen, show locations of each on sketch.