

MARION

F 2019

10-06-78

MISSISSIPPI BOARD OF WATER COMMISSIONERS

416 North State Street

Jackson, Mississippi 39201

WATER WELL DRILLERS LOG

Oct 6

date well completed

1978 Remus well ser

firm name

Marion

county well located

LANDOWNER:	description of formations encountered	from	to
Clyde Smith Jr. Pt Komarova (mailing address)			
	sand & gravel	30	68
	Red Chalk	68	75
	Gravel & sand	75	125
	White Chalk	125	165
	fine sand	165	195
	coarse sand	195	215
	fine gravel	215	230

WELL LOCATION:  
 sec. 36 T 4 N R. 19 W  
 0 1/2 miles N-NW of Popworth  
 (distance) (direction) (nearest town)

WELL PURPOSE: home  
 (home, irrigation, municipal, industrial)


- WELL COMPLETION DATA:
- (1) diameter (inches) 4"
  - (2) total depth (feet) 230
  - (3) static water level (feet) 160 below top of ground.
  - (4) casing plastic (material), bottom (depth)
  - If telescope see back. (size)
  - (5) screen 10' (length), 220' (depth to top)
  - 4" (size), plastic (material)
  - (6) pump 1/2 hp (HP), 15 (yield gpm)
  - elect (type power)
  - (7) electric log no (yes or no)
  - (organization running log)
  - (8) how well bottom plugged wood plug

DRILLERS REMARKS:

Miss. Board of Water Comm.  
 FEB 15 1979  
 RECEIVED

If well telescopes please sketch and show depths.

GROUND LEVEL

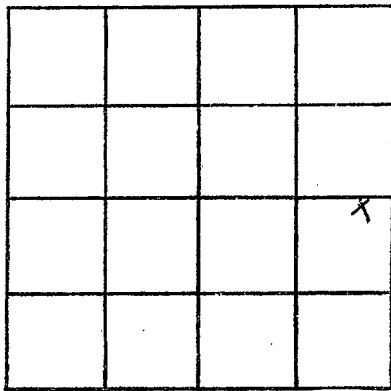

SECTION 36

Please indicate well location X.

ADDITIONAL INFORMATION

Lined area for additional information.

If more than one screen, show locations of each on sketch.