

MARION
 F 2070
 5-9-78

MISSISSIPPI
 BOARD OF WATER COMMISSIONERS
 416 North State Street
 Jackson, Mississippi 39201

WATER WELL DRILLERS LOG

TOM GRIFFITH
 PLUMBING & WELL SERVICE, INC.
 firm name

Marion
 county well located

May 9 1978
 date well completed

LANDOWNER:
 Mr. Danny Ray Morgan
 Rt. 1 Box 249 Poplarville, Miss.
 (mailing address)

description of formations encountered	from	to
top soil	0	1
clay	1	30
clay	30	40
sand	40	100

WELL LOCATION:
 sec 20 T 4N R 13E
 1 miles S of Moundtown
 (distance) (direction) (nearest town)

WELL PURPOSE: Home
 (home, irrigation, municipal, industrial)

- WELL COMPLETION DATA:
- (1) diameter (inches) 2"
 - (2) total depth (feet) 100 ft
 - (3) static water level (feet) 120 ft below top of ground.
 - (4) casing plastic 90 ft (material) (depth)
 2" (size) if telescope see back.
 - (5) screen 10 ft 90 ft (length) (depth to top)
 2" plastic (size) (material)
 - (6) pump 1 hp 10 (HP) (yield gpm)
 Electric (type power)
 - (7) electric log no (yes or no)
 n/a (organization running log)
 - (8) how well bottom plugged BWV


RECEIVED
 JUN 30 1978

DRILLERS REMARKS:

MISS. BD. OF WATER COMM

If well telescopes please sketch and show depths.

GROUND LEVEL

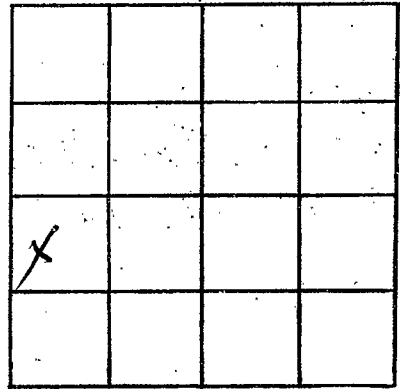

SECTION 20

Please indicate well location X.

ADDITIONAL INFORMATION

If more than one screen,
show locations of each on sketch.