

MARION

F 2021

6-8-78

MISSISSIPPI BOARD OF WATER COMMISSIONERS  
416 North State Street  
Jackson, Mississippi 39201

WATER WELL DRILLERS LOG

6/8 1978 Hollinger Well Service Marion  
date well completed firm name county well located

LANDOWNER:	description of formations encountered	from	to
(mailing address)			
Kearson Beal RT1 Morgantown MS	SAND GRAVEL CHINA CLAY	0	20
	SAND GRAVEL CHINA CLAY	140	200
	SAND GRAVEL	200	290
		290	350

WELL LOCATION:

sec. 28 T 40N R 13E  
3 miles S of Morgantown  
(distance) (direction) (nearest town)


WELL PURPOSE: Pond  
(home, irrigation, municipal, industrial)

WELL COMPLETION DATA:

- (1) diameter (inches) 2"
- (2) total depth (feet) 350
- (3) static water level (feet) Flow below top of ground
- (4) casing pvc (material), (depth), (size) if telescope see back.
- (5) screen 30 (length), 320 (depth to top), 2" (size), pvc (material)
- (6) pump Flow well 2" (HP), Flow (yield gpm), None (type power)
- (7) electric log (yes or no)
- (organization running log)

(8) how well bottom plugged sand SHARK


DRILLERS REMARKS: Excellent well

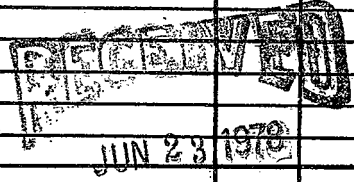

MISS. BD. OF WATER COMMISSIONERS

If well telescopes please sketch and show depths.

GROUND LEVEL

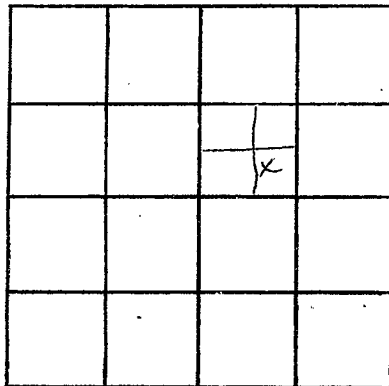

SECTION 28

Please indicate well location X.

ADDITIONAL INFORMATION

If more than one screen,  
show locations of each on sketch.