

MARION

F 2022

6/12/78

MISSISSIPPI  
 BOARD OF WATER COMMISSIONERS  
 416 North State Street  
 Jackson, Mississippi 39201

WATER WELL DRILLERS LOG

6/12 1978 Hollingsworth Well Service Marion  
 date well completed firm name county well located

LANDOWNER: Ellen Sherrill

RT 1

Foxworth, MS  
 (mailing address)

description of formations encountered

from

to

clay gravel chert 0 80  
 sand gravel 80 140

WELL LOCATION:

sec. 25 T 4N R 19 E  
 W

4 miles W of Anderson town  
 (distance) (direction) (nearest town)

WELL PURPOSE: Home  
 (home, irrigation, municipal, industrial)

WELL COMPLETION DATA:

- (1) diameter (inches) 4"
- (2) total depth (feet) 140
- (3) static water level (feet) 70 <sup>below</sup> <sub>above</sub> top of ground.
- (4) casing PVC, 130, (material) (depth)  
 (size) if telescope see back.
- (5) screen 10', 130, (length) (depth to top)  
 4", PVC, (size) (material)
- (6) pump 1/2, 12, (HP) (yield gpm)  
 elect, (type power)
- (7) electric log (yes or no)

(organization running log)

(8) how well bottom plugged Sand  
 SHARK


DRILLERS REMARKS: Good well

RECEIVED  
 JUN 23 1978

MISSISSIPPI BOARD OF WATER COMMISSIONERS

If well telescopes please sketch and show depths.

GROUND LEVEL

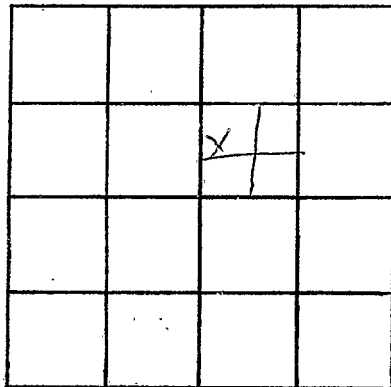

SECTION 25

Please indicate well location X.

ADDITIONAL INFORMATION

If more than one screen,  
show locations of each on sketch.