

MARION
 F2023
 C-29-78

MISSISSIPPI
 BOARD OF WATER COMMISSIONERS
 416 North State Street
 Jackson, Mississippi 39201

WATER WELL DRILLERS LOG

6/29 1978 Hollingsworth Well S. Marion
 date well completed firm name county well located

LANDOWNER: Earl Luter
Rt 7 Box 353
Columbia, MS
 (mailing address)

description of formations encountered	from	to
CLAY	0	50
GRAVEL	50	100
CHALK	100	140
SAND		

WELL LOCATION:
 sec. 8 T. 40 N. R. 12 W.
2 miles E of Expose
 (distance) (direction) (nearest town)

WELL PURPOSE: Home
 (home, irrigation, municipal, industrial)

WELL COMPLETION DATA:
 (1) diameter (inches) 2"
 (2) total depth (feet) 140
 (3) static water level (feet) 50 ^{below} _{above} top of ground.
 (4) casing pvc, 135,
 (material) (depth)
 _____ if telescope see back.
 (size)
 (5) screen 5, 135
 (length) (depth to top)
2", pvc
 (size) (material)
 (6) pump 1, 8
 (HP) (yield gpm)
elect
 (type power)
 (7) electric log _____
 (yes or no)

 (organization running log)
 (8) how well bottom plugged sand
SARK


DRILLERS REMARKS: Very good well

RECEIVED
 AUG 14 1978

MISS. BD. OF WATER COMM.

If well telescopes please sketch and show depths.

GROUND LEVEL

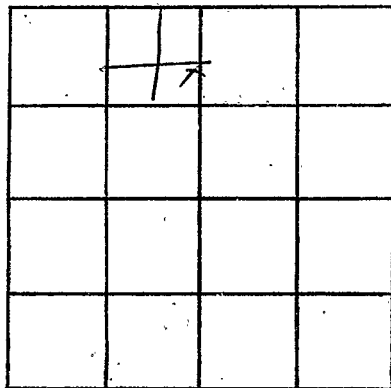

SECTION 8

Please indicate well location X.

ADDITIONAL INFORMATION

If more than one screen,
show locations of each on sketch.