

MAYION  
F 2025  
8-18-79

MISSISSIPPI  
BOARD OF WATER COMMISSIONERS  
416 North State Street  
Jackson, Mississippi 39201

WATER WELL DRILLERS LOG


8-18 1979 Hollinger MAYION  
date well completed firm name county well located

| LANDOWNER: Clem Pearce<br>RT1  | description of formations encountered | from     | to         |
|--|---------------------------------------|----------|------------|
| Morgantown, MS<br>(mailing address)  | Clay, Chalk, sand<br>Per gravel       | 0<br>100 | 100<br>120 |
| <b>WELL LOCATION:</b><br>sec. 12 T. 4 N. R. 19 E.<br>S                  W<br>5 miles NW of Morgantown<br>(distance) (direction) (nearest town)   |                                       |          |            |
| <b>WELL PURPOSE:</b><br>(home, irrigation, municipal, industrial)  |                                       |          |            |
| <b>WELL COMPLETION DATA:</b><br>(1) diameter (inches) 2"<br>(2) total depth (feet) 120<br>(3) static water level (feet) 100 (below above top of ground.)<br>(4) casing pvc, 115, (material) (depth)<br>(size) if telescope see back.<br>(5) screen 5, 115 (length) (depth to top)<br>2, pvc (size) (material)<br>(6) pump 1/2, 10 (HP) (yield gpm)<br>elect (type power)<br>(7) electric log (yes or no)<br>(organization running log) |                                       |          |            |
| (8) how well bottom plugged sand & CHALK   |                                       |          |            |
| <b>DRILLERS REMARKS:</b> Very good   |                                       |          |            |

Rec'd 9/21/79  
Dnr. LW

If well telescopes please sketch and show depths.

GROUND LEVEL

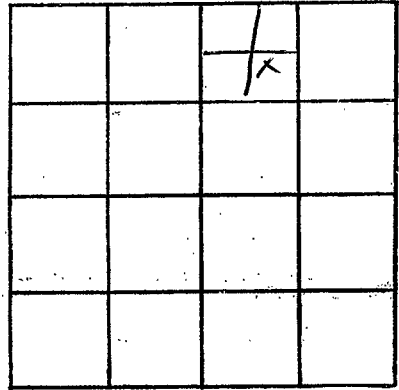

SECTION 12

Please indicate well location X.

ADDITIONAL INFORMATION

Lined area for additional information.

If more than one screen, show locations of each on sketch.