

Marion
F-2026

MISSISSIPPI
 BOARD OF WATER COMMISSIONERS
 416 North State Street
 Jackson, Mississippi 39201

WATER WELL DRILLERS LOG
 TOM GRIFFITH

1979 PLUMBING & WELL SERVICE, INC.

Marion

date well completed

firm name

county well located

LANDOWNER:

Mr. Luther Stringer
Rt. 3 Box 94 P. Joubert
 (mailing address) Miss

description of formations encountered

from to

Top Soil 0 1
Clay 1 6
Shale 6 27
Chalk 27 31
Sand 31 20

WELL LOCATION:

sec. 28 T. 28 N. R. 12 E. S. 4
2 miles N of Joubert
 (distance) (direction) (nearest town)

WELL PURPOSE:

(home, irrigation, municipal, industrial) Home

WELL COMPLETION DATA:

- (1) diameter (inches) 2"
- (2) total depth (feet) 70 ft.
- (3) static water level (feet) 22 ft. below top of ground.
- (4) casing plastic 110 ft.
 (material) (depth)
2" If telescope see back.
 (size)
- (5) screen 10 ft. 110 ft.
 (length) (depth to top)
2" plastic
 (size) (material)
- (6) pump 1 HP 10
 (HP) (yield gpm)
Electric
 (type power)
- (7) electric log No
 (yes or no)

(organization running log)

(8) how well bottom plugged Back Wash Valve

DRILLERS REMARKS:


DEPT. OF NATURAL RESOURCES
 BUREAU OF LAND & WATER RESOURCES

NOV 21 1979

RECEIVED

If well telescopes please sketch and show depths.

GROUND LEVEL

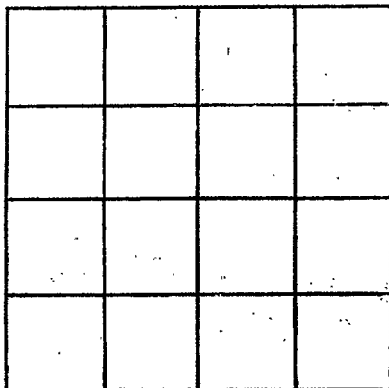

SECTION _____

Please indicate well location X.

ADDITIONAL INFORMATION

If more than one screen, show locations of each on sketch.