

MARION
F 2027

MISSISSIPPI
BOARD OF WATER COMMISSIONERS
416 North State Street
Jackson, Mississippi 39201

WATER WELL DRILLERS LOG

5/1/80
date well-completed

Tom Hight pl no well Marion
firm name county well located

LANDOWNER: Mrs. Kay Marshall	description of formations encountered	from	to
(mailing address)			
Bt 1, Foxworth vms	Top soil	0	4
	Sub ground	4	30
	Chalk	30	70
	Sand	70	125

WELL LOCATION:
sec. 21 T 4 N R 19 E
7 6
2 miles North of Morgan Town
(distance) (direction) (nearest town)

WELL PURPOSE: Domestic
(home, irrigation, municipal, industrial)

WELL COMPLETION DATA:


- (1) diameter (inches) 2 3/4
- (2) total depth (feet) 125
- (3) static water level (feet) 4 below top of ground.
- (4) casing Alum. 105
(material) (depth)
2 If telescope see back.
(size)
- (5) screen 20 105
(length) (depth to top)
2 Plastic
(size) (material)
- (6) pump NO NO
(HP) (yield gpm)
elec.
(type power)
- (7) electric log NO
(yes or no)

(organization running log)
- (8) how well bottom plugged B. W. V.

DRILLERS REMARKS:

If well telescopes please sketch and show depths.

GROUND LEVEL

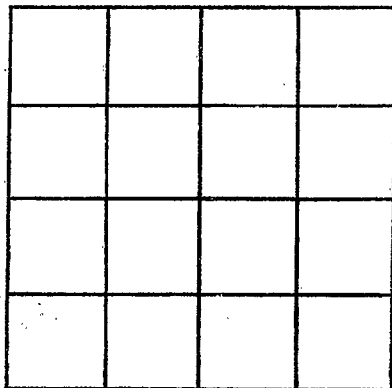

SECTION _____

Please indicate well location X.

ADDITIONAL INFORMATION

If more than one screen, show locations of each on sketch.