

Marion

~~F 34~~  
 F 2028  
 9/18/79

MISSISSIPPI  
 BOARD OF WATER COMMISSIONERS  
 416 North State Street  
 Jackson, Mississippi 39201

WATER WELL DRILLERS LOG

Sept. 18 19 79 *News with Ser* *Marion*  
 date well completed firm name county well located

LANDOWNER:	description of formations encountered	from	to
<i>Charles Powell</i> <i>unknown</i> (mailing address)			
WELL LOCATION:	<i>Red sand</i>	<i>12</i>	<i>90</i>
sec. <i>30</i> T. <i>4</i> N. R. <i>19</i> E. <i>13E</i>	<i>Slightly sand</i>	<i>30</i>	<i>143</i>
<i>6</i> miles <i>W, NW</i> of <i>Foxworth</i>	<i>White &amp; blue Chalk</i>	<i>143</i>	<i>175</i>
(distance) (direction) (nearest town)	<i>Sand (fine)</i>	<i>175</i>	<i>205</i>
WELL PURPOSE: <i>new house</i>	<i>Coarse sand</i>	<i>205</i>	<i>220</i>
(home, irrigation, municipal, industrial)			
WELL COMPLETION DATA:			
(1) diameter (inches) <i>4"</i>			
(2) total depth (feet) <i>250</i>			
(3) static water level (feet) <i>145</i> below top of ground.			
(4) casing <i>plastic bottom</i> (material) (depth)			
(5) screen <i>10"</i> (length) <i>210'</i> (depth to top)			
<i>4"</i> (size) <i>plastic</i> (material)			
(6) pump <i>3/4 HP</i> (HP) <i>12</i> (yield gpm)			
<i>1/2 HP</i> (type power)			
(7) electric log <i>no</i> (yes or no)			
(organization running log)			
(8) how well bottom plugged <i>wood plug</i>			
DRILLERS REMARKS:			


DEPT. OF NATURAL RESOURCES  
 BUREAU OF LAND & WATER RESOURCES

SEP 2 - 1980

RECEIVED

If well telescopes please sketch and show depths.

GROUND LEVEL

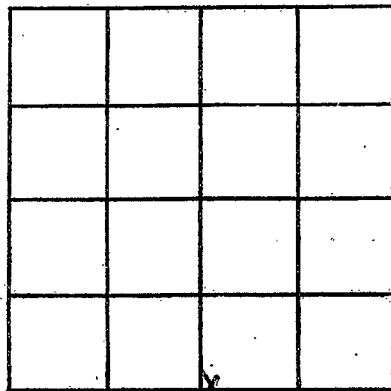

SECTION 30

Please indicate well location X.

ADDITIONAL INFORMATION

If more than one screen, show locations of each on sketch.