

Marion
F 2029

MISSISSIPPI
 BOARD OF WATER COMMISSIONERS
 416 North State Street
 Jackson, Mississippi 39201

WATER WELL DRILLERS LOG

10-1-90 19 TOM GRIFFITH MARION
 date well completed firm name county well located

LANDOWNER: Quinn Morgan
Rd 2 FORTWORTH
 (mailing address)

description of formations encountered	from	to
<u>SAND</u>	<u>1</u>	<u>20</u>
<u>GRAVEL</u>	<u>20</u>	<u>150</u>

WELL LOCATION:
 sec. 11 T. 4 N. R. 22 E. W. 3
5 miles N of MORGANTOWN
 (distance) (direction) (nearest town)

WELL PURPOSE: HOME
 (home, irrigation, municipal, industrial)

- WELL COMPLETION DATA:
- (1) diameter (inches) 2"
 - (2) total depth (feet) 150'
 - (3) static water level (feet) 100' below top of ground.
 - (4) casing PLASTIC, 130'
 (material) (depth)
 - 2" If telescope see back.
 (size)
 - (5) screen 20', 130'
 (length) (depth to top)
 - 2", PLASTIC
 (size) (material)
 - (6) pump 2, 10
 (HP) (yield gpm)
 - PLASTIC
 (type power)
 - (7) electric log NO
 (yes or no)
 - (organization running log)
 - (8) how well bottom plugged BACK WASH VASE

DRILLERS REMARKS:


DEPT. OF NATURAL RESOURCES
 BUREAU OF LAND & WATER

OCT - 6 1980

RECEIVED

If well telescopes please sketch and show depths.

GROUND LEVEL

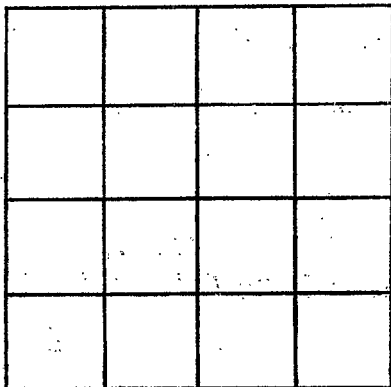

SECTION _____

Please indicate well location X.

ADDITIONAL INFORMATION

If more than one screen,
show locations of each on sketch.