

MARION  
F 2030

MISSISSIPPI  
BOARD OF WATER COMMISSIONERS  
416 North State Street  
Jackson, Mississippi 39201

12

8/6/80  
Aug 6  
date well completed

WATER WELL DRILLERS LOG

90 Henry Miller Marion  
firm name county well located

LANDOWNER:  
Kenneth Neal  
Rt. Fodsworth  
(mailing address)

description of formations encountered	from	to
residual clay	0	35
Red sand & gravel	35	108
Gravel	108	130
Chalky sand	130	195
Coarse sand & pea gravel	190	214

WELL LOCATION:  
sec. 31 T. 4 N R. 19 E 13E  
4 miles ENE of Fodsworth  
(distance) (direction) (nearest town)

WELL PURPOSE: home  
(home, irrigation, municipal, industrial)

WELL COMPLETION DATA:

(1) diameter (inches) 4"

(2) total depth (feet) 214

(3) static water level (feet) 145 below top of ground

(4) casing plastic bottom  
(material) (depth)

(5) screen 10 204'  
(length) (depth to top)


4" plastic  
(size) (material)

(6) pump 1 1/2 15  
(HP) (yield gpm)

electric  
(type power)

(7) electric log no  
(yes or no)

(organization running log)

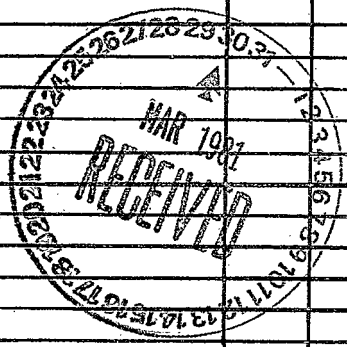


(8) how well bottom plugged  
No other plug

DRILLERS REMARKS:

If well telescopes please sketch and show depths.

GROUND LEVEL

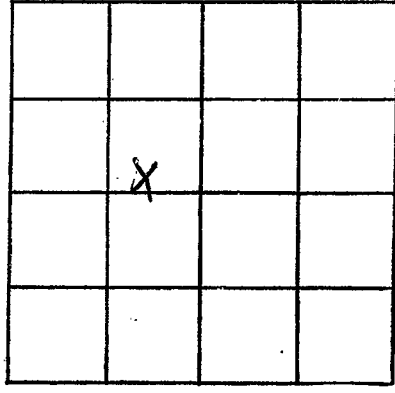

SECTION 31

Please indicate well location X.

ADDITIONAL INFORMATION

A series of horizontal lines for writing additional information.

If more than one screen, show locations of each on sketch.