

MISSISSIPPI DEPARTMENT OF NATURAL RESOURCES

Bureau of Land and Water Resources

Southport Mall

P.O. Box 10631

Jackson, Mississippi 39209

WATER WELL DRILLERS LOG

Marie
F 2032
6-22-81

6-22-81 date well completed Dunaway Plumbing firm name Marie county well located

LANDOWNER: Armelia Thomas
Route 7 Box 35
Columbia, Mo. 39416
 (mailing address)

description of formations encountered	from	to
Top Soil	0	2
clay	2	21
sand & gravel	21	49
Chalk	49	97
sand	97	103
Chalk & shale	103	154
sand	154	176
Chalk	176	184
sand	184	224

WELL LOCATION:
 sec. 6 T. 40 N. R. 19 E. S. 1 W. Expose
 (distance) (direction) (nearest town)

WELL PURPOSE:
 home, irrigation, municipal, industrial

WELL COMPLETION DATA:

(1) diameter (inches) 4 in.

(2) total depth (feet) 224

(3) static water level (feet) 91 below/above top of ground.

(4) casing PVC, 224 (material), (depth)

2 in. (size) if telescope see back.

(5) screen 10 ft., 214 (length), (depth to top)

2 in. #8, PVC (size), (material)

(6) pump 2 (HP), (yield gpm)

(type power)

(7) electric log (yes or no)

(organization running log)

(8) how well bottom plugged sand shale

DRILLERS REMARKS:


DEPT. OF NATURAL RESOURCES
 BUREAU OF LAND & WATER RESOURCES

JUL 16 1981

RECEIVED

If well telescopes please sketch and show depths.

GROUND LEVEL

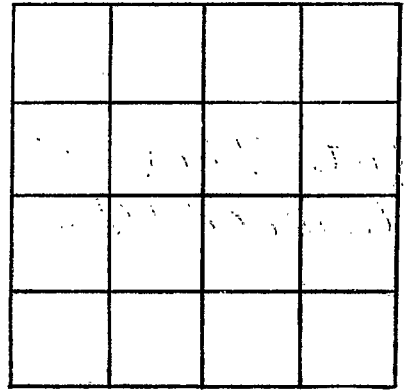

SECTION _____

Please indicate well location X.

ADDITIONAL INFORMATION

If more than one screen,
show locations of each on sketch.