

MISSISSIPPI DEPARTMENT OF NATURAL RESOURCES

Bureau of Land and Water Resources

Southport Mall

P.O. Box 10631

Jackson, Mississippi 39209

WATER WELL DRILLERS LOG

Marion
F 2033
3-18-81

March 18 19 81 Rever Well in Marion
 date well completed firm name county well located

LANDOWNER:
Donald McKensie
Foerwirth
 (mailing address)

description of formations encountered	from	to
	<u>Red clay</u>	<u>0</u>
<u>Red sand</u>	<u>17</u>	<u>70</u>
<u>small gravel</u>	<u>70</u>	<u>86</u>
<u>shrub</u>		
<u>lumpy sand</u>	<u>86</u>	<u>100</u>
<u>Coarse sand</u>	<u>100</u>	<u>180</u>
<u>& fine gravel</u>		

WELL LOCATION:
 sec. 35 T. 4 N R. 19 E 13E
4 1/2 miles WNW of Foerwirth
 (distance) (direction) (nearest town)

WELL PURPOSE: home
 (home, irrigation, municipal, industrial)

WELL COMPLETION DATA:

(1) diameter (inches) 4"

(2) total depth (feet) 180

(3) static water level (feet) 80 below top of ground.

(4) casing plastic bottom
 (material) (depth)

1 if telescope see back.
 (size)

(5) screen 5' 175'
 (length) (depth to top)

4" plastic
 (size) (material)

(6) pump 1/2 10
 (HP) (yield gpm)


electric
 (type power)

(7) electric log no
 (yes or no)

 (organization running log)

(8) how well bottom plugged:
Backwash

DRILLERS REMARKS:
Replaced Rod
 pump

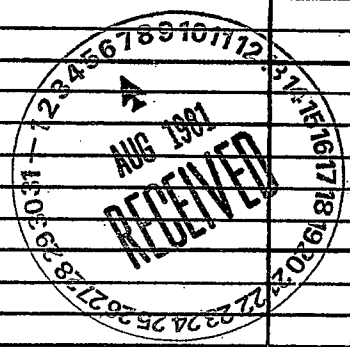

If well telescopes please sketch and show depths.

GROUND LEVEL

		X	

SECTION 36

Please indicate well location X.

ADDITIONAL INFORMATION

If more than one screen,
show locations of each on sketch.