

Marion
 F 2034
 6-4-81

MISSISSIPPI
 BOARD OF WATER COMMISSIONERS
 416 North State Street
 Jackson, Mississippi 39201
 WATER WELL DRILLERS LOG

6-4 1981 Hallinger Marion
 date well completed firm name county well located

LANDOWNER: J. H. Spurgeon	description of formations encountered	from	to
Box 111 Columbia, MS (mailing address)			
	CHALK sand, gravel	0	35
	CHALK	35	180
	SAND	180	227

WELL LOCATION:
 sec. 5 T. 4 N. R. 2 E. P. 10
 1 miles NW of Morgantown
 (distance) (direction) (nearest town)

WELL PURPOSE:
 (home, irrigation, municipal, industrial)


- WELL COMPLETION DATA:
- (1) diameter (inches) 2"
 - (2) total depth (feet) 227
 - (3) static water level (feet) 10 below top of ground
 - (4) casing PVC (material) (depth) (size) if telescope see back.
 - (5) screen 5 (length) 8 (depth to top) (size) (material)
 - (6) pump 1 (HP) 8 (yield gpm) elect (type power)
 - (7) electric log (yes or no)
 - (8) how well bottom plugged sand slick

DRILLERS REMARKS: good well

DEPT. OF NATURAL RESOURCES
 BUREAU OF LAND & WATER RESOURCES


AUG 26 1981

RECEIVED

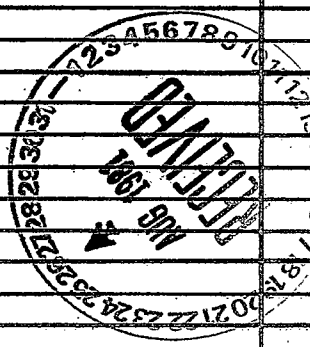

If well telescopes please sketch and show depths.

GROUND LEVEL

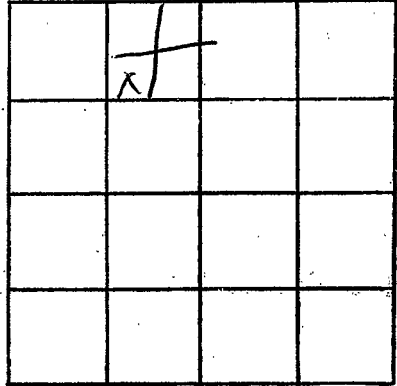

SECTION 7

Please indicate well location X.

ADDITIONAL INFORMATION

Lined area for additional information.

If more than one screen, show locations of each on sketch.