

Marion
F236

MISSISSIPPI
 BOARD OF WATER COMMISSIONERS
 416 North State Street
 Jackson, Mississippi 39201

WATER WELL DRILLERS LOG

12-28- 19 88
 date well completed

TOM GRIFFITH
 DRILLING & WELL SERVICE

2211 N. GIBSON AVE.
 JACKSON, MISSISSIPPI 39202

Marion
 county well located

LANDOWNER: Ben Routh

814 main st
Columbus MS
 (mailing address)

description of formations encountered

from to

Top soil	0	1
Chalk	1	20
Sand		
Sand	20	40

WELL LOCATION:

sec. 25 T. 4 (N) R. 13E
4 miles N of Columbus
 (distance) (direction) (nearest town)

WELL PURPOSE: house
 (home, irrigation, municipal, industrial)

WELL COMPLETION DATA:

- (1) diameter (inches) 2
- (2) total depth (feet) 40
- (3) static water level (feet) 30 below above top of ground.
- (4) casing PVC, 40,
 (material) (depth)
2 if telescope see back.
 (size)
- (5) screen 10, 30
 (length) (depth to top)
2, PVC
 (size) (material)
- (6) pump 1/2, 10
 (HP) (yield gpm)
Elect
 (type power)
- (7) electric log no
 (yes or no)

(organization running log)

(8) how well bottom plugged BWB

DEPT. OF NATURAL RESOURCES
 BUREAU OF LAND & WATER RESOURCES


DRILLERS REMARKS:

JUN - 9 1982

RECEIVED

If well telescopes please sketch and show depths.

GROUND LEVEL

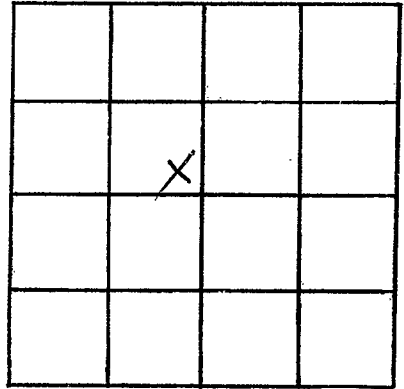

SECTION 25

Please indicate well location X.

ADDITIONAL INFORMATION

If more than one screen,
show locations of each on sketch.