

MISSISSIPPI DEPARTMENT OF NATURAL RESOURCES

Bureau of Land and Water Resources

Southport Mall

P.O. Box 10631

Jackson, Mississippi 39209

WATER WELL DRILLERS LOG

TOM GRIFFITH

1983 PLUMBING & WELL SERVICE INC.

Marion

MARION
F 2040
4-11-83

4-11 date well completed

320 MAYBERRY AVE.

county well located

LANDOWNER: <u>Billie Ray McKenzie</u>	Description of formations encountered	from	to
<u>RA-1</u>	<u>Topsoil</u>	<u>0'</u>	<u>1'</u>
<u>Foxworth, MS</u> (mailing address)	<u>Sand</u>	<u>1'</u>	<u>38'</u>
	<u>Chalk</u>	<u>38'</u>	<u>40'</u>
	<u>Sand & Pea Gravel</u>	<u>40'</u>	<u>80'</u>
<p>WELL LOCATION: <u>4N</u> <u>13E</u> ? sec. <u>30</u> T. <u>1N</u> R. <u>74E</u> <u>4</u> miles <u>W</u> of <u>Columbia</u> (distance) (direction) (nearest town)</p>			
<p>WELL PURPOSE: <u>home</u> (home, irrigation, municipal, industrial)</p>			
<p>WELL COMPLETION DATA:</p>			
(1) diameter (inches) <u>2"</u>			
(2) total depth (feet) <u>80'</u>			
(3) static water level (feet) <u>5'</u> below above top of ground.			
(4) casing <u>PVC</u> , <u>60'</u> (material) (depth)			
<u>N/A</u> if telescope see back. (size)			
(5) screen <u>20'</u> , <u>60'</u> (length) (depth to top)			
<u>2"</u> , <u>PVC</u> (size) (material)			
(6) pump <u>1/3</u> , <u>10</u> (HP) (yield gpm)			
<u>electric</u> (type power)			
(7) electric log <u>none</u> (yes or no)			
<u>N/A</u> (organization running log)			
(8) how well bottom plugged <u>BWV</u>			
DRILLERS REMARKS:			


DEPT. OF NATURAL RESOURCES
BUREAU OF LAND & WATER RESOURCES

MAY 18 1983

RECEIVED

If well telescopes please sketch and show depths.

GROUND LEVEL

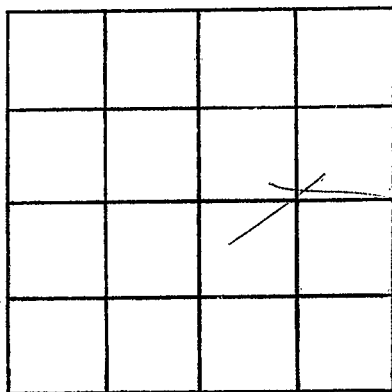

SECTION 30

Please indicate well location X.

ADDITIONAL INFORMATION

If more than one screen,
show locations of each on sketch.