

MISSISSIPPI DEPARTMENT OF NATURAL RESOURCES

Bureau of Land and Water Resources

Southport Mall

P.O. Box 10631

Jackson, Mississippi 39209

WATER WELL DRILLERS LOG

TOM GRIFFITH

PLUMBING & WELL SERVICE, INC.

Markon

Markon
F
2041

7/25/83 19

820 MAYSON AVE.
COLUMBIA, MS 39429

county well located

LANDOWNER: *Mary Stamps*
RL4 Box 477
Columbia, MS 39429
(mailing address)

description of formations encountered	from	to
<i>Chalk</i>	<i>0'</i>	<i>12'</i>
<i>sand & pea gravel</i>	<i>12'</i>	<i>30'</i>

WELL LOCATION:
sec *29* T *40* (N) R *13* E *13E*
2 miles *S* of *Estes*
(distance) (direction) (nearest town)

WELL PURPOSE: *Home*
(home, irrigation, municipal, industrial)

- WELL COMPLETION DATA:
- (1) diameter (inches) *2"*
 - (2) total depth (feet) *20'*
 - (3) static water level (feet) *8'* below above top of ground.
 - (4) casing *PVC* *10'*
(material) (depth)
 - NA* (size) if telescope see back.
 - (5) screen *10"* *20'*
(length) (depth to top)
 - 2"* *PVC*
(size) (material)
 - (6) pump *1/2* *10*
(HP) (yield gpm)
 - Elev.*
(type power)
 - (7) electric log *NA*
(yes or no)
 - NA*
(organization running log)
 - (8) how well bottom plugged *1300V*

DRILLERS REMARKS:


DEPT OF NATURAL RESOURCES
BUREAU OF LAND & WATER RESOURCES

FEB 13 1984

RECEIVED

If well telescopes please sketch and show depths.

GROUND LEVEL

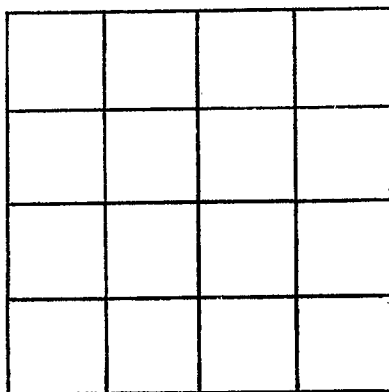

SECTION _____

Please indicate well location X.

ADDITIONAL INFORMATION

If more than one screen,
show locations of each on sketch.