

MISSISSIPPI DEPARTMENT OF NATURAL RESOURCES
Bureau of Land and Water Resources
 Southport Mall
 P.O. Box 10631
 Jackson, Mississippi 39209
WATER WELL DRILLERS LOG

Morgan
 F2042

10-17 19 83 Hollins Madison
 date well completed firm name county well located

LANDOWNER: Clinton Morgan
RT1, Box 79
Foxworth MS
 (mailing address)

description of formations encountered	from to	
<u>Red clay, sand</u>	<u>0</u>	<u>20</u>
<u>clay</u>	<u>20</u>	<u>65</u>
<u>coarse sand, gravel</u>	<u>65</u>	<u>105</u>

WELL LOCATION:
 sec. 28 T 4 N S R 13 E W
2 miles NW of Morgan
 (distance) (direction) (nearest town)

WELL PURPOSE:
 (home, irrigation, municipal, industrial)

WELL COMPLETION DATA:


- (1) diameter (inches) 2"
- (2) total depth (feet) 105
- (3) static water level (feet) 20 below top of ground.
- (4) casing pvc 105
 (material) (depth)
 if telescope see back.
 (size)
- (5) screen 5 100
 (length) (depth to top)
2" pvc
 (size) (material)
- (6) pump NO
 (HP) (yield gpm)
did not furnish pump
 (type power)
- (7) electric log
 (organization running log)
- (8) how well bottom plugged sand
stickic

DRILLERS REMARKS: good well

DEPT. OF NATURAL RESOURCES
 BUREAU OF LAND & WATER RESOURCES
RECEIVED
 NOV 21 1983

If well telescopes please sketch and show depths.

GROUND LEVEL

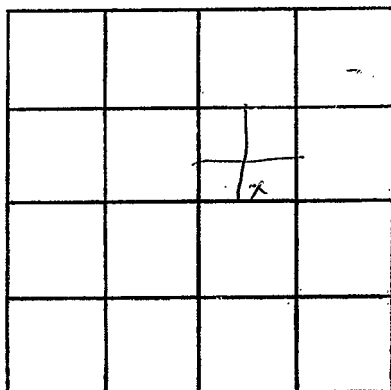

SECTION 28

Please indicate well location X.

ADDITIONAL INFORMATION

If more than one screen, show locations of each on sketch.