

MISSISSIPPI DEPARTMENT OF NATURAL RESOURCES

Bureau of Land and Water Resources

Southport Mall

P.O. Box 10631

Jackson, Mississippi 39209

WATER WELL DRILLERS LOG

Marion
F
2043

10-21 1983
 date well completed

Hollinger
 firm name

Marion
 county well located

LANDOWNER: Vatore Jacob

Rt 7 or Donald Davis

Columbia Ms
 (mailing address)

description of formations encountered	from	to
<u>Red clay</u>	<u>0</u>	<u>20</u>
<u>chalk</u>	<u>20</u>	<u>120</u>
<u>coarse sand, gravel</u>	<u>120</u>	<u>160</u>

WELL LOCATION:

sec. 12 T. 4 (N) R. 19 (E) W

AT miles Expose of (distance) (direction) (nearest town)

WELL PURPOSE:

(home, irrigation, municipal, industrial)

WELL COMPLETION DATA:

- (1) diameter (inches) 2"
- (2) total depth (feet) 160
- (3) static water level (feet) 50 below above top of ground.
- (4) casing PVC (material) (depth) _____ if telescope see back. (size)
- (5) screen 5 155 (length) (depth to top)
2 (size) PVC (material)
- (6) pump 1 8 (HP) (yield gpm)
elect (type power)
- (7) electric log (yes or no) _____
 (organization running log) _____


(8) how well bottom plugged sand
stick

DRILLERS REMARKS: Very good well

DEPT. OF NATURAL RESOURCES
 BUREAU OF LAND & WATER RESOURCES
 RECEIVED
 NOV 27 1983

If well telescopes please sketch and show depths.

GROUND LEVEL

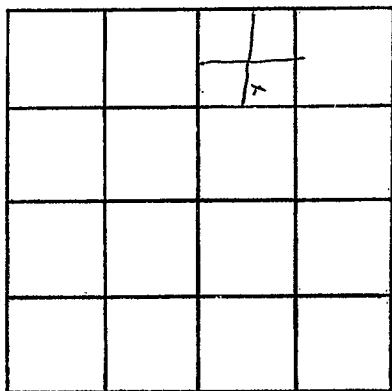

SECTION 12

Please indicate well location X.

ADDITIONAL INFORMATION

If more than one screen,
show locations of each on sketch.