

MISSISSIPPI DEPARTMENT OF NATURAL RESOURCES

Bureau of Land and Water Resources

Southport Mall

P.O. Box 10631

Jackson, Mississippi 39209

WATER WELL DRILLERS LOG

Marion
F
2044

11-3 1983 Hollingsen Marion
 date well completed firm name county well located

LANDOWNER: <u>Alberta Freeman</u>	description of formations encountered	from	to
<u>RT 7</u>	<u>Red clay, gravel</u>	<u>0</u>	<u>20</u>
<u>Columbia</u>	<u>Chalk</u>	<u>20</u>	<u>140</u>
(mailing address)	<u>sand, gravel</u>	<u>140</u>	<u>180</u>
WELL LOCATION: sec. <u>18</u> T. <u>40</u> N. R. <u>13</u> E S W <u>1/2</u> miles <u>SE</u> of <u>Exposure</u> (distance) (direction) (nearest town)			
WELL PURPOSE: (home, irrigation, municipal, industrial)			
WELL COMPLETION DATA: (1) diameter (inches) <u>2</u> (2) total depth (feet) <u>180</u> (3) static water level (feet) <u>50</u> <u>below</u> above top of ground. (4) casing <u>pvc</u> <u>170</u> (material) (depth) (size) if telescope see back. (5) screen <u>10</u> <u>170</u> (length) (depth to top) <u>2"</u> <u>pvc</u> (size) (material) (6) pump <u>1</u> <u>12</u> (HP) (yield gpm) <u>elect</u> (type power) (7) electric log (yes or no) (organization running log) (8) how well bottom plugged <u>sand</u> <u>stone</u>			
DRILLERS REMARKS: <u>good well</u>			


DEPT. OF NATURAL RESOURCES
 BUREAU OF LAND & WATER RESOURCES

DEC - 9 1983

RECEIVED

If well telescopes please sketch and show depths.

GROUND LEVEL

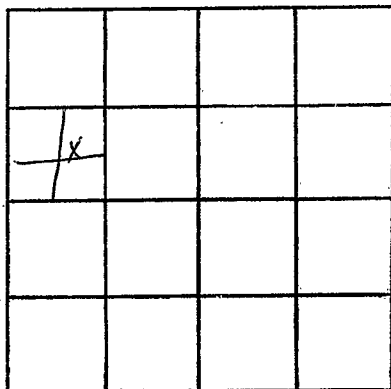

SECTION 18

Please indicate well location X.

ADDITIONAL INFORMATION

If more than one screen,
show locations of each on sketch.