

MISSISSIPPI DEPARTMENT OF NATURAL RESOURCES
Bureau of Land and Water Resources
 Southport Mall
 P.O. Box 10631
 Jackson, Mississippi 39209
WATER WELL DRILLERS LOG

Monion
F
2046


4-11 1984 *F. J. G. Well Dr.* *Monion*
 date well completed firm name county well located

LANDOWNER:	description of formations encountered	from	to
<i>Dallas Gay</i> <i>P.R. Foxworth</i> (mailing address)	<i>Red clay</i> <i>fine sand & gravel</i> <i>course sand</i>	0 20 90	20 90 160
WELL LOCATION: sec <u>33</u> T <u>4</u> N R <u>13</u> E S W <u>7</u> miles <u>N</u> of <u>Foxworth</u> (distance) (direction) (nearest town)			
WELL PURPOSE: <u>Home</u> (home, irrigation, municipal, industrial)			
WELL COMPLETION DATA: (1) diameter (inches) <u>4</u> (2) total depth (feet) <u>160</u> (3) static water level (feet) <u>5</u> below above top of ground. (4) casing <u>PVC</u> , <u>92</u> , (material) (depth) <u>4</u> if telescope see back. (size) (5) screen <u>8</u> , <u>92</u> , (length) (depth to top) <u>4</u> , <u>PVC</u> (size) (material) (6) pump <u>1/2</u> , <u>60</u> (HP) (yield gpm) <u>elm</u> (type power) (7) electric log <u>no</u> (yes or no) (organization running log) (8) how well bottom plugged <u>solid</u>			
DRILLERS REMARKS:			

DEPT. OF NATURAL RESOURCES
 BUREAU OF LAND & WATER RESOURCES
 APR 26 1984
RECEIVED

If well telescopes please sketch and show depths.

GROUND LEVEL

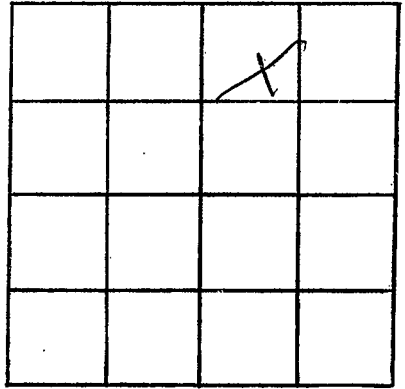

SECTION 33

Please indicate well location X.

ADDITIONAL INFORMATION

If more than one screen,
show locations of each on sketch.