

MISSISSIPPI DEPARTMENT OF NATURAL RESOURCES

Bureau of Land and Water Resources

Southport Mall

P.O. Box 10631

Jackson, Mississippi 39209

WATER WELL DRILLERS LOG

MARION  
F 2047

4-12 1984  
date well completed

Hollins  
firm name

Marion  
county well located

LANDOWNER: William Kings

description of formations encountered

from

to

Expose

Chalk

0

40

Goss, Ms.

sand, gravel

40

85

(mailing address)

pen gravel, sand

85

140

WELL LOCATION:

sec. 12 T. 4N

R. 19 E

1 miles SW of Expose  
(distance) (direction) (nearest town)

WELL PURPOSE:

Home

(home, irrigation, municipal, industrial)

WELL COMPLETION DATA:

- (1) diameter (inches) 2"
- (2) total depth (feet) 140
- (3) static water level (feet) 30 below top of ground.

- (4) casing PVC, 130  
(material) (depth)

if telescope see back.  
(size)

- (5) screen 10, 130  
(length) (depth to top)

2, PVC  
(size) (material)

- (6) pump 1, 12 GPM  
(HP) (yield gpm)

elect.  
(type power)

- (7) electric log (yes or no)

(organization running log)

- (8) how well bottom plugged sand  
shrink

DRILLERS REMARKS: Good well


DEPT. OF NATURAL RESOURCES  
BUREAU OF LAND & WATER RESOURCES

JUL 31 1984

RECEIVED

If well telescopes please sketch and show depths.

GROUND LEVEL

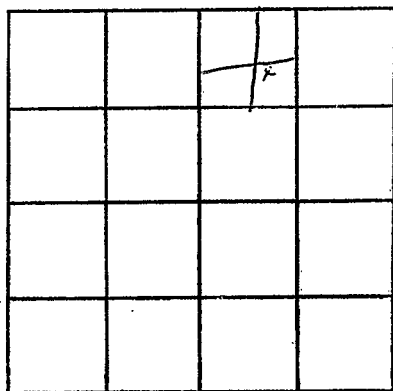

SECTION 12

Please indicate well location X.

ADDITIONAL INFORMATION

If more than one screen,  
show locations of each on sketch.