

MISSISSIPPI DEPARTMENT OF NATURAL RESOURCES

Bureau of Land and Water Resources

Southport Mall

P.O. Box 10631

Jackson, Mississippi 39209

WATER WELL DRILLERS LOG

MARION
F 248

6-30 19 89 date well completed
Hollinger firm name
Marion county well located

LANDOWNER:	description of formations encountered	from	to
Mary Morgan RT-1	Clay, Chalk, sand pea gravel	0	100
Morganston (mailing address)		100	140
WELL LOCATION:			
sec 9 T 4N R 13E S W			
1 miles AT of Morganston (distance) (direction) (nearest town)			
WELL PURPOSE: (home, irrigation, municipal, industrial)			
WELL COMPLETION DATA:			
(1) diameter (inches) 4"			
(2) total depth (feet) 140			
(3) static water level (feet) 12 below top of ground.			
(4) casing PVC, 130, (material) (depth)			
(size) if telescope see back.			
(5) screen 10, 130 (length) (depth to top)			
4, PVC (size) (material)			
(6) pump 1 1/2, 16 (HP) (yield gpm)			
elect (type power)			
(7) electric log (yes or no)			
(organization running log)			
(8) how well bottom plugged: sand SHANK			
DRILLERS REMARKS: Very good well			


MISSISSIPPI DEPARTMENT OF NATURAL RESOURCES
BUREAU OF LAND & WATER RESOURCES

JUL 31 1989

RECEIVED

If well telescopes please sketch and show depths.

GROUND LEVEL

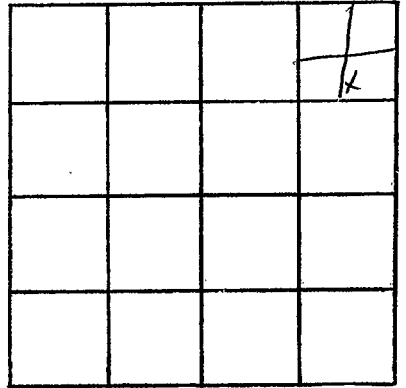

SECTION 17

Please indicate well location X.

ADDITIONAL INFORMATION

If more than one screen,
show locations of each on sketch.