

MISSISSIPPI DEPARTMENT OF NATURAL RESOURCES

Bureau of Land and Water Resources

Southport Mall

P.O. Box 10631

Jackson, Mississippi 39209

WATER WELL DRILLERS LOG

Morgan
F2049

10-26-84 1984
date well completed

Hollinger
firm name

Marion
county well located

LANDOWNER: John Perntson

RT 1

Morgan town
(mailing address)

description of formations encountered

from to

<u>0-10 clay</u>	<u>0</u>	<u>10</u>
<u>Sandy clay</u>	<u>10</u>	<u>30</u>
<u>pen gravel</u>	<u>30</u>	<u>67</u>

WELL LOCATION:

sec. 18 T. 4 (N) R. 13E
(distance) (direction) (nearest town)

WELL PURPOSE:

(home) irrigation, municipal, industrial

WELL COMPLETION DATA:

- (1) diameter (inches) 4 "
- (2) total depth (feet) 67
- (3) static water level (feet) 6 below top of ground.
- (4) casing PVC, 57,
(material) (depth)
If telescope see back.
(size)
- (5) screen 10, 57
(length) (depth to top)
4, PVC
(size) (material)
- (6) pump 1/2, 8
(HP) (yield gpm)
elect.
(type power)
- (7) electric log _____
(yes or no)
(organization running log)

(8) how well bottom plugged sand
SNARK

DRILLERS REMARKS: good well


DEPT. OF NATURAL RESOURCES
BUREAU OF LAND & WATER RESOURCES

NOV 20 1984

RECEIVED

If well telescopes please sketch and show depths.

GROUND LEVEL

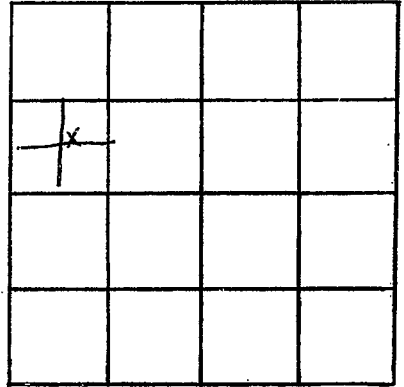

SECTION 18

Please indicate well location X.

ADDITIONAL INFORMATION

If more than one screen,
show locations of each on sketch.