

MISSISSIPPI DEPARTMENT OF NATURAL RESOURCES

Bureau of Land and Water Resources

Southport Mall

P.O. Box 10631

Jackson, Mississippi 39209

WATER WELL DRILLERS LOG

MARION
F 2050

6-1-1985 date well completed Hollinsworth Well Service firm name Marion county well located

LANDOWNER:	description of formations encountered	from	to
Sonnie Hayes Expose, MS (mailing address)			
WELL LOCATION:			
sec. 12-T-4(N) _S R-19-E(W)			
miles 1.4 (distance) AT (direction) of Expose (nearest town)			
WELL PURPOSE:			
(home, irrigation, municipal, industrial)			
WELL COMPLETION DATA:			
(1) diameter (inches) 2"			
(2) total depth (feet) 87			
(3) static water level (feet) 20 below top of ground.			
(4) casing PVC (material), 87 (depth)			
(size) If telescope see back.			
(5) screen 10 (length), 77 (depth to top)			
4 (size), PVC (material)			
(6) pump 1 (HP), 9 (yield gpm)			
elect (type power)			
(7) electric log (yes or no)			
(organization running log)			
(8) how well bottom plugged Sand shale			
DRILLERS REMARKS: Very good well			


RECEIVED

AUG 15 1985

Department of Natural Resources
Bureau of Land & Water Resources

If well telescopes please sketch and show depths.

GROUND LEVEL

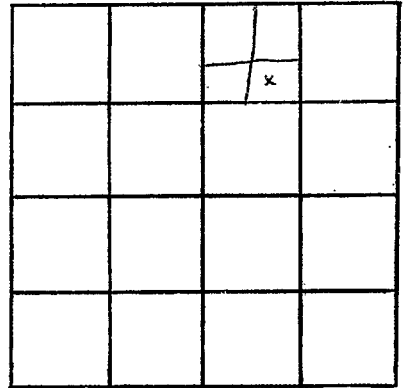

SECTION 12

Please indicate well location X.

ADDITIONAL INFORMATION

If more than one screen,
show locations of each on sketch.