

MARION
F2051

MISSISSIPPI DEPARTMENT OF NATURAL RESOURCES
Bureau of Land and Water Resources
Southport Mall
P.O. Box 10631
Jackson, Mississippi 39209
WATER WELL DRILLERS LOG

6-21 1985
date well completed

Hollinsen
firm name

MARION
county well located

LANDOWNER:	description of formations encountered	from	to
Johnathon QUINN Rt 1 Foxworth (mailing address)			
WELL LOCATION: sec 32 T 4 (N) S R 19 E 13E 9 miles W of Foxworth (distance) (direction) (nearest town)			
WELL PURPOSE: (home, irrigation, municipal, industrial)			
WELL COMPLETION DATA:			
(1) diameter (inches) 4"			
(2) total depth (feet) 120			
(3) static water level (feet) 30 below top of ground.			
(4) casing PVC 110 (material) (depth)			
(size) if telescope see back.			
(5) screen 10 110 (length) (depth to top)			
4 PVC (size) (material)			
(6) pump 1HP 12 (HP) (yield gpm)			
elect (type power)			
(7) electric log (yes or no)			
(organization running log)			
(8) how well bottom plugged sand SHARK			
DRILLERS REMARKS: good well			


RECEIVED

AUG 15 1985

Department of Natural Resources
Bureau of Land & Water Resources

If well telescopes please sketch and show depths.

GROUND LEVEL

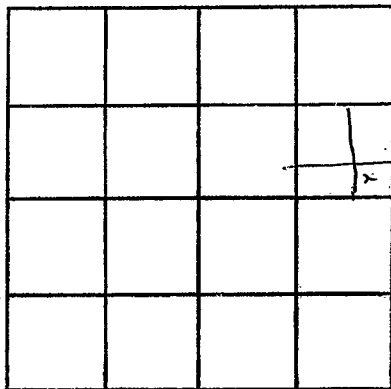

SECTION 32

Please indicate well location X.

ADDITIONAL INFORMATION

If more than one screen,
show locations of each on sketch.