

MISSISSIPPI DEPARTMENT OF NATURAL RESOURCES

Bureau of Land and Water Resources

Southport Mall

P.O. Box 10631

Jackson, Mississippi 39209

WATER WELL DRILLERS LOG

Marion
F252

10-21 1985
date well completed

Hollinger
firm name

Marion
county well located

LANDOWNER: George Expose
RT 4
Columbia, MS. 39483
(mailing address)

description of formations encountered

from

to

<u>sand gravel</u>	<u>0</u>	<u>20</u>
<u>sandy clay, clay</u>	<u>20</u>	<u>45</u>
<u>clay, sand gravel</u>	<u>45</u>	<u>8.6</u>

WELL LOCATION:

sec. 12 T 4 N R 19 E
AT miles (distance) of Expose (nearest town)

WELL PURPOSE: Home
(home, irrigation, municipal, industrial)

WELL COMPLETION DATA:

(1) diameter (inches) 2"
(2) total depth (feet) 86
(3) static water level (feet) 15 below above top of ground.

(4) casing PVC 76
(material) (depth)

(size) if telescope see back.

(5) screen 10 76
(length) (depth to top)

2 PVC
(size) (material)

(6) pump NONE
(HP) (yield gpm)


(type power)

(7) electric log (yes or no)

(organization running log)

(8) how well bottom plugged sand shank

DRILLERS REMARKS: Good well

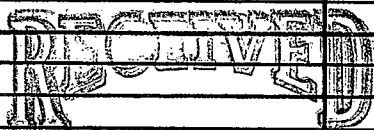


NOV 20 1985

Department of Natural Resources
Bureau of Land & Water Resources

If well telescopes please sketch and show depths.

GROUND LEVEL

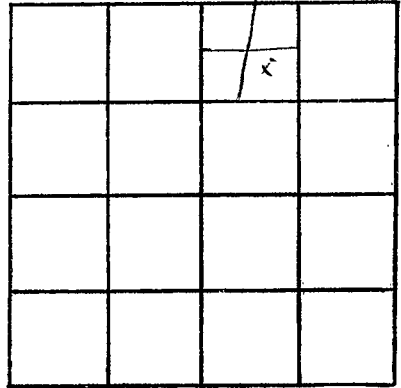

SECTION 12

Please indicate well location X.

ADDITIONAL INFORMATION

If more than one screen,
show locations of each on sketch.