

MARION
F
2054

MISSISSIPPI DEPARTMENT OF NATURAL RESOURCES
Bureau of Land and Water Resources
Southport Mall
P.O. Box 10631
Jackson, Mississippi 39209
WATER WELL DRILLERS LOG

7-10-1986 date well completed
Hollinsworth firm name
MARION county well located

LANDOWNER: Thomas White
RT 4 BOX 533
Columbia MS
(mailing address)

description of formations encountered	from	to
	Chalk, clay sand, pebbles	0
	15	85

WELL LOCATION:
sec. 3 T. 5 N. R. 19 E
2 1/2 miles S of Goss
(distance) (direction) (nearest town)

WELL PURPOSE:
(home, irrigation, municipal, industrial)

WELL COMPLETION DATA:

- (1) diameter (inches) 4"
- (2) total depth (feet) 85
- (3) static water level (feet) 20 below above top of ground.
- (4) casing PVC 85
(material) (depth)
if telescope see back.
- (5) screen 10 75
(length) (depth to top)
4 PVC
(size) (material)
- (6) pump 1 8
(HP) (yield gpm)
elect
(type power)
- (7) electric log (yes or no)
- (organization running log)
- (8) how well bottom plugged sand
SHARIC

DRILLERS REMARKS: good well


RECEIVED

JUL 11 1986

MISSISSIPPI DEPARTMENT OF NATURAL RESOURCES

If well telescopes please sketch and show depths.

GROUND LEVEL

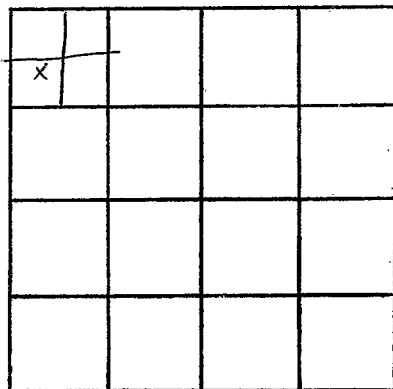

SECTION 3

Please indicate well location X.

ADDITIONAL INFORMATION

If more than one screen,
show locations of each on sketch.