

**MISSISSIPPI DEPARTMENT OF ENVIRONMENTAL QUALITY**  
Bureau of Land and Water Resources

P. O. Box 10631  
Jackson, MS 39289-0631  
**WATER WELL DRILLERS LOG**

COUNTY WELL LOCATED <i>Monroe</i>	
WELL NUMBER <i>F 2056</i>	CODED
DATE WELL COMPLETED <i>Dec 20-90</i>	

PERMIT NUMBER
NAME OF DRILLING FIRM <i>FISHER &amp; WELLS</i>

NAME & MAILING ADDRESS OF LANDOWNER <i>Clarence Blawatt</i> <i>P.O. Foxworth, ms.</i>		
WELL LOCATION: SEC	TOWNSHIP	RANGE
<i>32</i>	<i>4</i>	<i>N 13 E</i>
DISTANCE	DIRECTION	NEAREST TOWN
<i>2 1/2</i>	<i>Miles NW</i>	<i>of Foxworth</i>
OTHER LANDMARK		
WELL PURPOSE: Home, Irrigation, Municipal, Industrial, Fish Pond, etc. <i>Home</i>		

<b>PUMP DATA</b>		
PUMP TYPE (Circle One): <input checked="" type="checkbox"/> Submersible, <input type="checkbox"/> Turbine, <input type="checkbox"/> Jet <input type="checkbox"/> Flowing Well, Other (Describe) _____		
POWER TYPE (Circle One): <input checked="" type="checkbox"/> Electric, <input type="checkbox"/> Tractor, <input type="checkbox"/> Diesel, <input type="checkbox"/> Gasoline, <input type="checkbox"/> Butane, Other (Describe) _____ H/P _____		
Pump Capacity (GPM)	No. of Stages	Setting Depth
<i>10</i>	<i>12</i>	<i>130</i> FT.
PUMP TEST		
Well yielded <i>20</i> GPM with a drawdown of <i>4</i> ft. after <i>1</i> hours of pumping		

<b>WELL DATA</b>		
Well Depth <i>167</i>	Casing Diameter (In.) <i>4</i>	Casing Length (Ft.) <i>157</i>
Type of Casing <i>PVC</i>	Hole Depth <i>167</i>	Depth to Static Water Level <i>103</i>
TYPE OF COMPLETION: (Circle One or More): <input checked="" type="checkbox"/> Gravel Packed, <input type="checkbox"/> Underreamed, <input type="checkbox"/> Telescoped, <input type="checkbox"/> Natural Development, <input type="checkbox"/> Open Hole, <input type="checkbox"/> Other (Describe) _____		
Top of Lap Pipe or Reduction in Casing		
FEET <input type="checkbox"/> IF TELESCOPED OR MORE THAN ONE SCREEN: USE BACK PAGE		

<b>LOG DATA</b>	
TYPE OF LOG RUN (Circle One): <input checked="" type="checkbox"/> No Log Run, <input type="checkbox"/> Electric, <input type="checkbox"/> Gamma Ray, <input type="checkbox"/> Density, <input type="checkbox"/> Sonic, <input type="checkbox"/> Neutron, Other (Describe) _____	
Name of Organization Running Log	


<b>SCREEN DATA</b>		
Diameter - Inches <i>4</i>	Length - Feet <i>10</i>	Slot Size - Inches <i>.014</i>
Screen Type <i>PVC</i>	Depth to Bottom - Feet <i>167</i>	

<b>GEOLOGIC DATA (Office Use Only)</b>			
Surface Elev.	Geologic Unit	Unit Thickness	Depth to Top
Subs. SWL	Date	Analysis	Aquifer Test
Driller's Remarks			

DESCRIPTION OF FORMATIONS ENCOUNTERED	FROM	TO	FORMATIONS (Continued)	FROM	TO
<i>Red clay</i>	<i>0</i>	<i>15</i>	<b>DISCOVER</b>		
<i>Red sand</i>	<i>15</i>	<i>147</i>			
<i>Coarse sand &amp; gravel</i>	<i>147</i>	<i>167</i>			
			<b>JAN 24 1991</b>		
			Dept. of Environmental Quality Bureau of Land & Water Resources		
			IF MORE SPACE IS NEEDED, USE BACK		

If well telescopes please sketch and show depths.

GROUND LEVEL

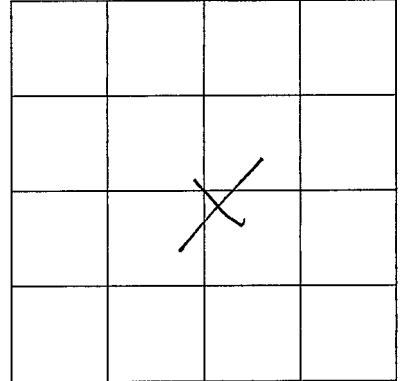

SECTION 32

Please indicate well location X.

ADDITIONAL INFORMATION

If more than one screen,  
show location of each on sketch.