

MISSISSIPPI DEPARTMENT OF ENVIRONMENTAL QUALITY
Bureau of Land and Water Resources

P. O. Box 10631
Jackson, MS 39289-0631
WATER WELL DRILLERS LOG

COUNTY WELL LOCATED Marion	
WELL NUMBER F 2058	CODED
DATE WELL COMPLETED 1-5-90	

PERMIT NUMBER 0-402
NAME OF DRILLING FIRM Tom Griffith
Water Well

NAME & MAILING ADDRESS OF LANDOWNER Poss Thornhill		
Rt-1		
Columbia Miss		
WELL LOCATION: SEC	TOWNSHIP	RANGE
21	4	N 13 W
DISTANCE	DIRECTION	NEAREST TOWN
6 Miles	west	Columbia
OTHER LANDMARK Morgantown Road		
WELL PURPOSE: Home, Irrigation, Municipal, Industrial, Fish Pond, etc. Home		

PUMP DATA		
PUMP TYPE (Circle One): Submersible, Turbine, Jet, Flowing Well, Other (Describe) Customer Pump		
POWER TYPE (Circle One): Electric, Tractor, Diesel, Gasoline, Butane, Other (Describe) _____ H/P _____		
Pump Capacity (GPM)	No. of Stages	Setting Depth FT.
PUMP TEST		
Well yielded 12 GPM with a drawdown of _____ ft. after _____ hours of pumping		

WELL DATA		
Well Depth 90	Casing Diameter (In.) 2	Casing Length (Ft.) 80
Type of Casing	Hole Depth 90	Depth to Static Water Level 15
TYPE OF COMPLETION: (Circle One or More): Natural Development , Gravel Packed, Underreamed, Telescoped, Open Hole, Other		
Top of Lap Pipe or Reduction in Casing FEET IF TELESCOPED OR MORE THAN ONE SCREEN: USE BACK PAGE		

LOG DATA	
TYPE OF LOG RUN (Circle One): No Log Run, Electric, Gamma Ray, Density, Sonic, Neutron, Other (Describe) _____	
Name of Organization Running Log	

SCREEN DATA		
Diameter - Inches 2	Length - Feet 10	Slot Size - Inches .010
Screen Type PVC-stot	Depth to Bottom - Feet 90	


GEOLOGIC DATA (Office Use Only)			
Surface Elev.	Geologic Unit	Unit Thickness	Depth to Top
Subs. SWL	Date	Analysis	Aquifer Test
Driller's Remarks			

DESCRIPTION OF FORMATIONS ENCOUNTERED	FROM	TO
Top soil Top soil	0	5
Sand	5	90

FORMATIONS (Continued)	FROM	TO
RECEIVED		
JAN 17 1991		
Dept. of Environmental Quality Bureau of Land & Water Resources		
IF MORE SPACE IS NEEDED, USE BACK		

If well telescopes please
sketch and show depths.

GROUND LEVEL

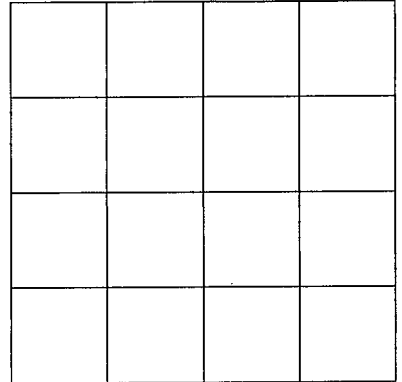

SECTION _____

Please indicate well location X.

ADDITIONAL INFORMATION

If more than one screen,
show location of each on sketch.