

MARION

F

~~2066~~

2066

4-29

date well completed

19

MISSISSIPPI
BOARD OF WATER COMMISSIONERS
416 North State Street
Jackson, Mississippi 39201

WATER WELL DRILLERS LOG
TOM GRIFFITH
PLUMBING & WELL SERVICE, INC.

320 W. HIGHWAY AVE.
COLUMBIA, MISS. 39209

Marion
county well located

LANDOWNER:

James Ferrell McLeod
P.O. Box 116 - Popworth
(mailing address) Miss.

description of formations encountered

from

to

Top Soil
Clay
Fossiliferous
Clay
Sand

0 2
2 30
30 45
45 130
130 190

WELL LOCATION:

sec. 2 T. 4 N. R. 19 E.
S. 5 miles N of Columbus
(distance) (direction) (nearest town)

WELL PURPOSE:

Home
(home, irrigation, municipal, industrial)

WELL COMPLETION DATA:

- (1) diameter (inches) 2"
- (2) total depth (feet) 180 ft.
- (3) static water level (feet) 100 ft. ^{100 ft. below} above top of ground.
- (4) casing (material) plastic (depth) 170 ft.
2" (size) if telescope see back.
- (5) screen 10 ft. 170 ft.
(length) (depth to top)
2" (size) plastic (material)
- (6) pump 1 H.P. (HP) (yield gpm).
Elev (type power)
- (7) electric log no (yes or no)
n/a (organization running log)

(8) how well bottom plugged
B.W. Valve

DRILLERS REMARKS:


RECEIVED

MAY 24 1970

MISS. BD. OF WATER COMM

If well telescopes please sketch and show depths.

GROUND LEVEL

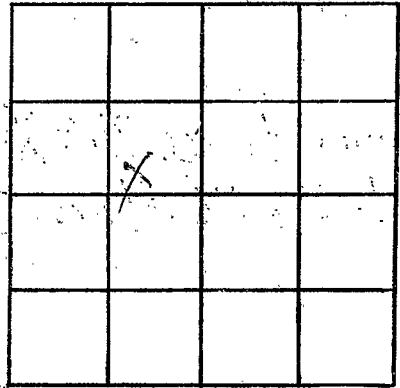

SECTION 5

Please indicate well location X.

ADDITIONAL INFORMATION

If more than one screen,
show locations of each on sketch.