

MISSISSIPPI DEPARTMENT OF NATURAL RESOURCES

Bureau of Land and Water Resources

Southport Mall

P.O. Box 10631

Jackson, Mississippi 39209

WATER WELL DRILLERS LOG

Marion
~~8 2067~~
F 2067

6-18

date well completed

1982 Hollinsec

firm name

Marion

county well located

LANDOWNER:

Stuart Borden

description of formations encountered

from

to

Rt 1 Box 169
Foxworth, MS
 (mailing address)

Sand gravel
Red clay
sand, gravel

0 60
60 100
100 130

WELL LOCATION:

sec 31 T 40 N R 12 E
2 miles AIN of Foxworth
 (distance) (direction) (nearest town)

WELL PURPOSE:

(home, irrigation, municipal, industrial)

WELL COMPLETION DATA:

- (1) diameter (inches) 4"
- (2) total depth (feet) 130
- (3) static water level (feet) 70 ^{below}/_{above} top of ground.
- (4) casing PVC, 120,
 (material) (depth)
 (size) if telescope see back.
- (5) screen 10, 120
 (length) (depth to top)
4, PVC
 (size) (material)
- (6) pump 1/2, 8
 (HP) (yield gpm)
elect
 (type power)
- (7) electric log
 (yes or no)

copy

(organization running log)

(8) how well bottom plugged sand
shank

DRILLERS REMARKS: Good


DEPT. OF NATURAL RESOURCES
 BUREAU OF LAND & WATER RESOURCES

NOV 16 1982

RECEIVED

If well telescopes please sketch and show depths.

GROUND LEVEL

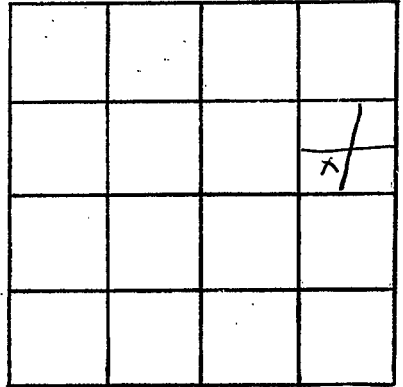

SECTION 31

Please indicate well location X.

ADDITIONAL INFORMATION

If more than one screen,
show locations of each on sketch.