

CODED

MISSISSIPPI
 BOARD OF WATER COMMISSIONERS
 416 North State Street
 Jackson, Mississippi 39201
 WATER WELL DRILLERS LOG

CODED CODED

Marion
D 8
2-19-69

Feb. 19th 19 69 Dean Drines Marion
 date well completed firm name county well located

LANDOWNER:
Melvin R. Deff
Rte. 1 Columbia
Miss. (mailing address)

description of formations encountered	from	to
<u>top soil</u>	<u>0</u>	<u>1'</u>
<u>clay</u>	<u>1'</u>	<u>6'</u>
<u>Chalk</u>	<u>6'</u>	<u>30'</u>
<u>fine sand</u>	<u>30'</u>	<u>45'</u>
<u>water sand</u>	<u>45'</u>	<u>60'</u>

WELL LOCATION:
 sec. 35 T 4 N R 18 E
3 miles East of Columbia
 (distance) (direction) (nearest town)

WELL PURPOSE: Home
 (home, irrigation, municipal, industrial)

WELL COMPLETION DATA:

(1) diameter (inches) 2"

(2) total depth (feet) 60'

(3) static water level (feet) 30 below above
 top of ground.

(4) casing Plastic, 55'
 (material) (depth)

_____ if telescope see back.
 (size)

(5) screen 5, 53
 (length) (depth to top)

2", Plastic
 (size) (material)

(6) pump _____ (HP) _____ (yield gpm)

_____ (type power)

(7) electric log _____ (yes or no)

_____ (organization running log)

(8) how well bottom plugged _____

DRILLERS REMARKS:

CODED


CODED

FEB 25 1969

MISS. BD. OF WATER CONTROL

If well telescopes please sketch and show depths.

GROUND LEVEL

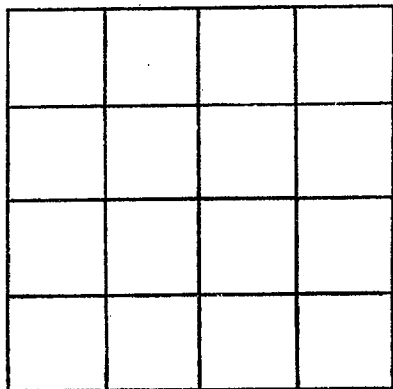

SECTION 35

Please indicate well location X.

ADDITIONAL INFORMATION

If more than one screen, show locations of each on sketch.