

CODED

CODED

MISSISSIPPI
BOARD OF WATER COMMISSIONERS
416 North State Street
Jackson, Mississippi 39201

WATER WELL DRILLERS LOG

CODED

Marion
49
2-10-68
2-11-68 19
date well completed

Udon Hines firm name
Marion county well located

LANDOWNER:
Vander Anderson
Route 3 Columbia
Miss. (mailing address)

description of formations encountered	from	to
	<u>Chalk</u>	<u>1</u>
<u>Sand</u>	<u>20</u>	<u>80</u>
<u>Water sand</u>	<u>80</u>	<u>110</u>

WELL LOCATION:
sec. 11 T. 4 N. R. 18 E.
6 miles NE of Columbia
(distance) (direction) (nearest town)

WELL PURPOSE: House
(home, irrigation, municipal, industrial)

WELL COMPLETION DATA:
(1) diameter (Inches) 2"
(2) total depth (feet) 110
(3) static water level (feet) 50 ^{below} _{above} top of ground.
(4) casing Plastic, 105'
(material) (depth)
_____ If telescope see back. _____
(size)
(5) screen 2" x 5', 105'
(length) (depth to top)
2", Gravel wall
(size) (material)
(6) pump _____ (HP) _____ (yield gpm)
_____ (type power)
(7) electric log no
(yes or no)
_____ (organization running log)
(8) how well bottom plugged _____

CODED

CODED


FEB 13 1968

MISS. Bd. of WATER COMMISSIONERS

DRILLERS REMARKS:

If well telescopes please sketch and show depths.

GROUND LEVEL

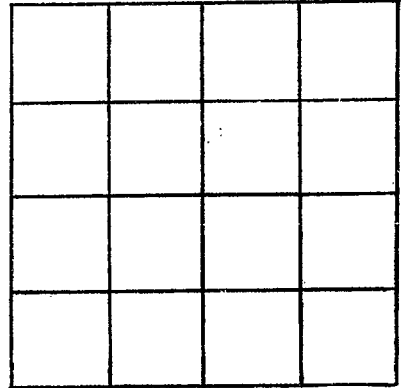

SECTION 11

Please indicate well location X.

ADDITIONAL INFORMATION

If more than one screen, show locations of each on sketch.