

G 10

2-19-63

WATER WELL DRILLERS LOG CODED

Date: 2-19, 1963, Driller: E. B. SHERPARD County: Marion

(Name)

(1) Owner of Land: George SANDERS

(Name)

Rt. 3 - Columbia, Miss.

(Address)

(2) Location: 1/4, 1/4, Sec. 28 4/8 T R

3 miles N.E. of COLUMBIA

(distance)

(direction)

(Nearest-Town)

(3) Topography: (Hilly) (Flat) (Level)

(4) Purpose of Well: Domestic

(Domestic Irrigation Municipal, Industrial, Other)

Description & Color of Materials Sand, Clay, Red Clay, Shell, etc.

Thick-ness Feet

Dep-Feet

GRAY SANDY CLAY	20'
GRAVEL & CLAY	40'
GRAVEL & SAND	60'
	80'
	100'

CODED

Information upon completion of well:

(1) Diameter: 2 inches.

(2) Total Depth: 86 feet.

(3) Water Level: 50' feet below top of ground.

(4) Cased to _____, Size _____


(5) Screen: Size 2", Length 5'

(6) Were any formations sealed against pollution? _____ yes, _____ no.

If YES depth of formation _____

Why _____

Drillers Remarks: _____

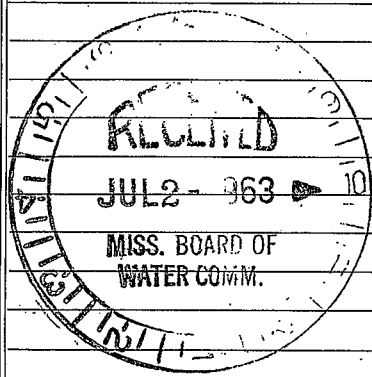

(Use Back Side)

Well No.

